

T27S BSM


Not found

3/2

~~2/1~~
~~1/1~~

0 ~~3/2~~
~~10/10~~

DIETZGEN NO. 385-6

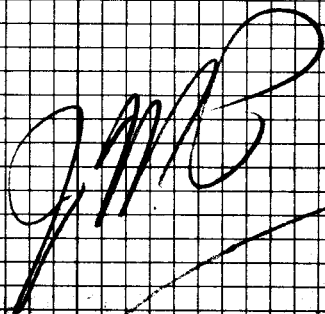

C. S. File No. 53/38⁴⁷