

S.E. Cor D.C. #39

T 275 85W

Found

From Map 5-47

Iron Rod 175[±] from D.C. cor.

Also P.A. Nail over D.C. cor.


I find this distance to be
175[±]

I Move West 0³ to correct distance
of 175[±]

Set $\frac{3}{4}$ " Iron Rod West 20⁰
for Ref. Point

22" W. Oak N 8W 29[±]
Scribed. S.E. D.C. #39 C.S. BT.

18" Cedar S 30 E 65[±]
P.A. Nail

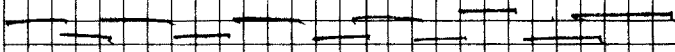

I Move this cor Pt West 0³
Because of slid Iron Rod &
Information of $\frac{3}{4}$ " Iron Pipe at
D.C. cor being badly bent at
the time P.A. Nail was set for
cor.

3-1-66
[Handwritten signature]

* 99
J.B.

C.S. File No. 52/30, 29

DIETZGEN NO. 385-6