

# Reference Section Cor.

NOTE - THIS CORNER IN  
 LOT 6 YERNCREST  
 SUBDIVISION

11-5-65

10	11	T 275
15	14	R 6 W

Found Brass Cap (Rem #100)


→ Catalpa Tree 520 E  
 384.5

→ Apple Tree N 57 W 416.5

## Referenced THIS:

NOTE - CHISELED + IN FACE OF CONCR.  
 CURB THIS ADDED NOV. 4 - 1965  
 J. Byrn

BRASS  
 CAP

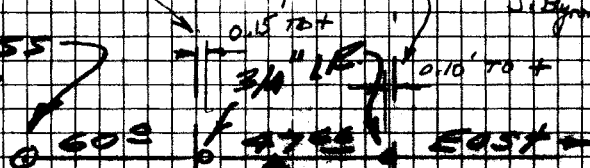

BRASS CAP  
 WILL PROBABLY  
 BE REMOVED  
 AS HOUSE WILL  
 BE BUILT OVER  
 TOP OF B.C.  
 LOCATION. L.L.

CURB TRUSS STREET

#129  
 + X

July 13, 1965

C. S. File No. 53/38 BR. - W.S.

DIETZEN NO. 386-6