


RENEW $\frac{1}{4}$ COR. $\frac{33}{4}$ T30S R6W
T31S

FOUND - BRASS CAP AT COR. &
ALL B.T.'S PER COR. #102 EXCEPT
NW B.T. NOW DEAD.

NEW B.T.

6" R. FIR BEARS S 78° E 28°
SCRIBED $\frac{1}{4}$ 34 C.B.T.

FENCE COR. THIS

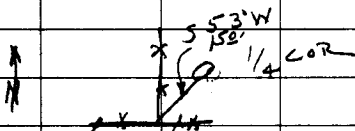

FILED
RECEIVED

NOV 21 1963

COUNTY SURVEYOR
DOUGLAS COUNTY, ORE.

+ * 00 ✓

CS 53/40-3