


RENEW NE COR. DLC 47

5151

T30S R6W

FOUND - 3/4" I.P. AND ROCK WITH  
+ ON TOP AT CORNER, SEC. COR. #47

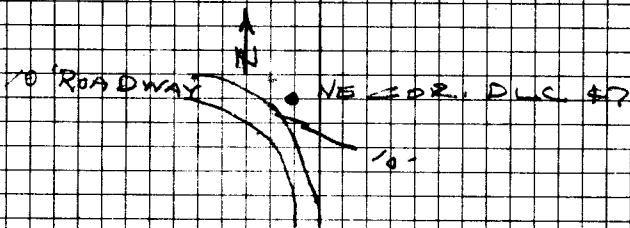

SET BRASS CAP ALONGSIDE COR.

STONE & MARK COUNTY SURVEYORS  
OFFICE 1964 T30S R6W

NE DLC 47.

NO TREES NEAR

POWER POLE C 80 17

BEARS 545' 610'

NORTH SOUTH FENCE

47.5' EAST OF COR.

JAN 23 - 69

U. I. B.  
M. I. D.  
G. I. K.

DIETZGEN NO. 385-6

116