

Renew $\frac{1}{4}$ 532 only of T305 R7W

Fd. at the South $\frac{1}{4}$ COR. of Sec. 32

only a "1918" G.L.O. BRASS cap MKd.

" $\frac{1}{4}$ 532 1918" & following B.T.s -

ORIG. 16" Now 16" B. OAK N. 9° W. 35' ft.

Down-Dead & Rotted. - Shows "532 B"
SCRIBE.

ORIG. 24" Now 36" Y. PINE N. 11° E. 53' ft.

Shows SCOR - a live. - we do NOT open.

we MARK new BT -

9" D. FIR N. $46\frac{1}{2}^{\circ}$ W. 11' ft.


Mkd. " $\frac{1}{4}$ 532 CS BT"

This COR. lies 162' ft. East of

N. $\frac{1}{4}$ of sec. 5 of T315 R7W.

July 7, 1965

V.R.P.
M.D.
T.C.

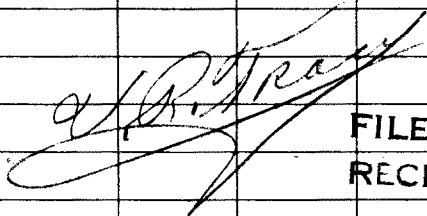

FILED
RECEIVED

JUL 7 1965

COUNTY SURVEYOR
DOUGLAS COUNTY, ORE.

#10/
+ * (1)
31-7-55

C. S. File No. 53/40 - 20