

Review Sec. Cor. <sup>511|512</sup> 514|513 T305 R7W

Fd. of Cor. ORIGINAL BT's as follows -

48" Now 42" Pine <sup>(S122)</sup> S. 70° W. 9<sup>2</sup> ft.

Showing good Scribe "514 305 7W"

36" Now 48" Pine (down) N. 85° E. 64<sup>2</sup> ft.

Shows "512 305 7W" Scribe

Both oaks gone. Set for Cor.

1" I.P. & BRASS Cap MKD. "COUNTY

SURVEYOR'S OFFICE 1964 T305

R7W <sup>511|512</sup> 514|513 " & New BT's -

7" D. FIR S. 15° W. 6<sup>9</sup> ft.

MKD. T305 R7W 514 CS BT

12" D. FIR S. 21° E. 16<sup>8</sup> ft.

MKD T305 R7W 513 CS BT

7" D. FIR N. 87° E. 20<sup>8</sup> ft.


MKD. T305 R7W 512 CS BT

NO TREE Close IN Sec. N. Fence

Cor. Bears S. 31° E. 5° FT. with Fence  
going S. & E.

August 26, 1964

V.R.T.  
M.D.  
J.B.

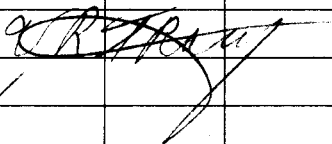

C. S. File No. 53/40-86