

Review S. $\frac{1}{16}$ 522/523 T255 R4W

Ed. at COR. one live BT & stamp
of other BT & BLM CROSS CAP

Mkd " S $\frac{1}{16}$ 522/523 1957". a

14" now 18" cedar (stamp) N. $6\frac{1}{2}^{\circ}$ E. 39³ ft.

shows " S $\frac{1}{16}$ 523 BT" scribe. stamp
is 42" high.

15" now 16" FIR N. $42\frac{1}{2}^{\circ}$ W. 68⁶ ft.

face pitched over. " S $\frac{1}{16}$ 52" visible.

we mark a new BT—

10" cedar S. 81° E. 31⁴ ft.


Mkd " S $\frac{1}{16}$ 523 CS BT "

COR. falls in E.-W. Fence Line.

JAN 25, 1965

U.R.T.

M.P.
J.B.

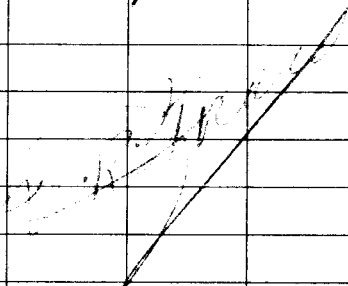

+ XV
80
#97

C. S. File No. 53/47