

Renew $\frac{1}{4}$ $\frac{528}{533}$ T255 R4W

Fd. BT: 25 follows -

ORIG. 16" Now 22" FIR (SN 29) S. 50° E. 19 $\frac{1}{2}$ ft.

upper SCAR previously opened & shows

FRAGMENTARY SCRIBE, we chop LOWER SCAR

out & find "T" Reverse & also find Reverse

" $\frac{1}{4}$ S" scribe on ground at Base of

TREE. NO TRACE of other ORIG. BT.

FIND UNRECORDED BT 25 follows -

41" D. FIR S. 77° W. 32 $\frac{1}{2}$ ft.

BARK scribed " $\frac{1}{4}$ S BT" Set 1" I.P.

& BRASS CAP MKD. "COUNTY SURVEYOR'S

OFFICE 1966 T255 $\frac{1}{4}$ $\frac{528}{533}$ R4W"

& MK. New BTs -

11" W. FIR S. 51° W. 9 $\frac{1}{2}$ ft.

MKD. " $\frac{1}{4}$ S 33 CS BT"

9" D. FIR N. 70° W. 11 $\frac{1}{2}$ ft.

MKD. " $\frac{1}{4}$ S 28 CS BT"


COR. lies approx. 150 ft. East of

CREEK. COURSE N.

May 26, 1966

V.R.T.
M.S.
J.H.

Don. DUSKIN of B.L.M.

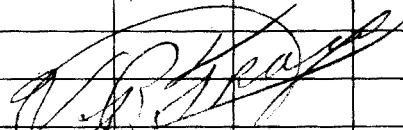

J.W.B.

C.S. File No. 53/47-9