

REN. T 25 S R 4 W COR. 19 | 20
SECS. 30 | 29

FD. COR. TREE UPROOTED &

ROLLED DOWN HILL APPROX. 20 FT.

N.W. OF COR.

FD. 20" FIR N 50° W 20 1/2 FT.

UPROOTED & DOWN.

FD. 32" FIR N 51° E 85° FT.

UPROOTED & DOWN. - SCRIBING VISIBLE ON FACE.

FD. 10" FIR S 19 3/4° W 104 1/2 FT. -

NOW DEAD SNAG - SCRIBING VISIBLE ON FACE.

FD. DOUG. FIR (NOW 22" DIAM.)

S 49 1/2° E 68 1/2 FT. - ALIVE & IN GOOD CONDITION. - SCRIBING VISIBLE ON PARTIALLY HEALED FACE.

AT COR. - (IN HOLE LEFT BY UPROOTED COR. TREE) SET IRON PIPE WITH BRASS CAP MKD. "COUNTY SURVEYOR'S OFFICE 1964 T 25 S R 4 W

S 19 | S 20"

S 30 | S 29

BLAZE & SCRIBE 3 NEW TREES!

14" DOUG. FIR S 37° W 78 1/2 FT

MKD. "T 25 S R 4 W S 30 CS BT"

16" DOUG. FIR N 20 1/2° W 47 1/2 FT.

MKD. "T 25 S R 4 W S 19 CS BT"

20" DOUG. FIR N 80° E 75° FT.

MKD. "T 25 S R 4 W S 20 CS BT"

COR. LIES ON VERY STEEP WEST SLOPE APPROX. 100 FT. WEST OF TOP OF RIDGE.

FEB. 27, 1964


+ * Milo E. Godfrey M.G. - W.S. - M.S. U.S. File No. 53/77-2

Section 19

Twp 25

Rge 4

Date: 10 Dec 63

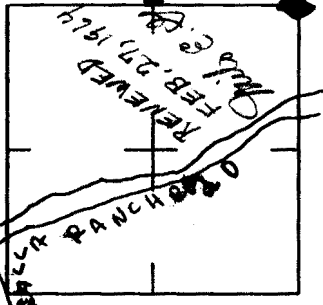

How was corner identified?

A FIR Tree IS THE CORNER

Condition of corner: The Tree IS

AND THROWN

COUSIN

Best route to reach corner: OUT PLAT "K" ROAD

TO GALLA RANCH ROAD (SEE MAP)

Other Remarks:

Quadrant	NE	NW	SE	SW
Species & Size				
Dist. & Bearing				
Condition of Scribe				
Original or Resurvey				
Appearance of B.T.				
Tags, Marks, etc.				

Thomas E. Haller
E.T.M. Signed

CS 53/47-21