

REN. TWPS. 25 & 26 S R 4 W $\frac{1}{4}$ $\frac{935}{32}$

AT COR. FD. G.L.O., BRASS CAP

SET IN 1957.

THE 10" FIR N 60° E 10 6 FT. IS
NOW DEAD SNAK. - SCRIBING PLAINLY VISIBLE.

THE 12" FIR S 49° W 9 5 FT. IS
UPROOTED & DOWN, - SCRIBING VISIBLE.

BLAZE & SCRIBE NEW TREES:

15" DOUG. FIR S 16° E 21 8 FT.

MKD. " $\frac{1}{4}$ S 2 C S BT "

13" DOUG. FIR N 70° W 42 2 FT.

MKD. " $\frac{1}{4}$ S 35 C S BT "

COR. IS ON POINT OF SMALL
SPUR SLOPING SOUTH; APPROXIMATELY
25 FT. SOUTH OF WIRE FENCE RUNNING
EAST & WEST; AND APPROX. 75 FT. EAST
OF GATE WHERE FENCE LINE CROSSES
NEW LOGGING ROAD.

AUG. 24, 1964

M.G.
M.S.

Milo E. Godfrey

+ * 8 /

T25-4 - #12
T26-4 #90

C.S. File No. 53/47-B

Section 35

Twp 25S

Rge 4


N

Date:

8/19/64

RENEWED. AUG. 24, 1964

Sub E. of Hwy

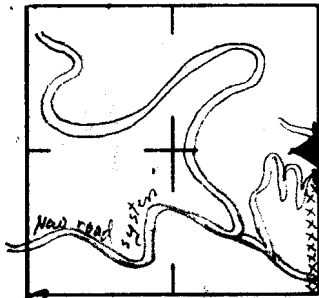

How was corner identified? Cadastral brass cap

1957

Condition of corner: Good

Gassey Cr. system. New

Best route to reach corner: Development leads into sec. 35. Old system also goes there. Spur road goes right past cor. Cor. is about 10' ESE of wire fence gate.

Other Remarks:

Both BT's seem to be lost. Both are small trees & both are dead. Should rescribe some new BT's sometime

John J. R...

Quadrant	SW	SE	SW
Species & Size	DF 12"	DF 10"?	
Dist. & Bearing			
Condition of Scribe	OK	OK	
Original or Resurvey	New	New	
Appearance of B.T.	Dead stub	Bloodwood	
Tags, Marks, etc.	✓	✓	✓

es 53/47-22