

Renew N.N.W. DLC. 49 T255 R4W

Ed. at cor. 1" steel shaft with

gear attached as recorded in Renewal #62. we find no trace of original

BTs. MARK new BTs. -

21" D. FIR N. 64 °E 4 <sup>2</sup>/<sub>3</sub> ft.

Mkd. "NNW DLC 49 CS BT"

10" D. FIR N. 26 °W. 17 <sup>3</sup>/<sub>4</sub> ft.


Mkd. "NNW DLC 49 CS BT"

This cor. lies in E.-W. Fence

2PROV 100° East of fence cor.

JUN 29, 1965

URT  
M.D.  
J.B.

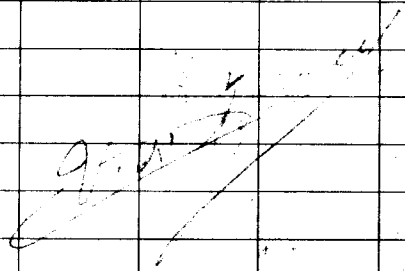

✓  
+X  
102