

REN, T 26 S R 5 W 1/4 S 1 S 31 32

✓ SET FROM SURVEY. - AT COR.

SET IRON PIPE WITH BRASS CAP MKD.

"COUNTY SURVEYOR'S OFFICE 1964

T 26 S R 5 W 1/4 S 1 S 31 32

BLAZE & SCRIBE NEW TREES:

16" INCENSE CEDAR N 31 1/2° W 45<sup>3</sup> FT.

MKD. " 1/4 S 31 C S BT "

5" WHITE OAK S 17° E 66<sup>7</sup> FT.


MKD. " 1/4 S 32 C S BT "

AN OLD BURNED OUT LAUREL STUMP

FITS BEARING & DIST. FOR DRIF.

S.W. B.T.

△ 510

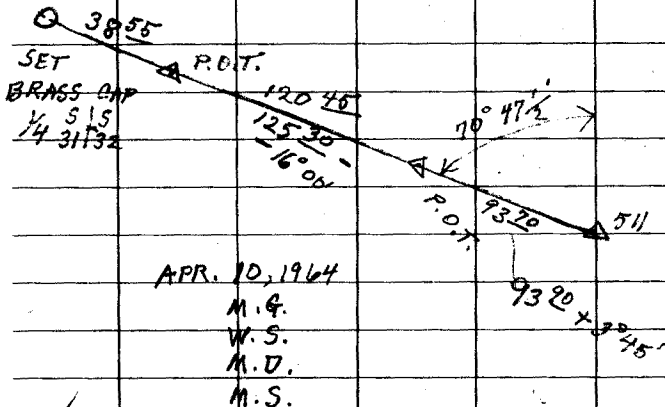

✓

Milo E. Godfrey

C.S. File No. 53/51-12