

REN. T 32 S R 5 W. CLOS. S 25
COR. S 36

(ON W. LINE T 32 S R 4 W)

AT COR. FD. YEWWOOD STAKE
SET BY WENDEROTH. - SCRIBED "C 5"
(REN # 85)

FD. DOUG. FIR (NOW 15" DIAM.)
N 39° W 39.7 FT. (TO FACE) - BOTH AXE
SCARS VERY PLAIN, BUT HEALED OYER. -
TREE IN GOOD CONDITION.

WENDEROTH'S S.W. TREE IS NOW
DEAD & DOWN. - SCRIBING VISIBLE,

FD. STUMP OF ORIG. S.W. TREE &
BURNED REMAINS OF ORIG. N.W. TREE.

AT COR. SET IRON PIPE WITH
BRASS CAP MKD. "COUNTY SURVEYOR'S
OFFICE 1964 T 32 S R 5 W CC

S 25 R 4 W" - RESET YEW POST ALONGSIDE.
S 36

BLAZE & SCRIBE ONE NEW TREE!

5" WHITE FIR S 73° W 14° FT.

MKD. "CC S 36 CS BT"

SEE REN.
85

JUNE 23, 1964

M.G.

Milo E. Godfrey

M.S.

NOT FD.

BYARS ORIG. COR. 25/30

(NOW A.P. ONLY ON RANGE LINE) ✓
30/31


22
+X

U.S. FILE NO. 53/52 40

CLOSING COR. FOR
SECS. 25 & 36 ONLY
REN. JUNE 23, 1964

Section 25 / ~~36~~
Twp 32S Rge ~~45~~ W

Date: 12/11/58

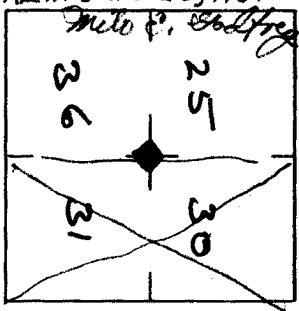

How was corner identified? Stake 2" x 2" x 2"

Condition of corner: Good

Best route to reach corner:

Other Remarks:

Quadrant	NE	NW	SE	SW
Species & Size		DF 12"		DF 8"
Dist. & Bearing		N 30° W 39 FT		S 15° W 15 FT
Condition of Scribe		36 S (Resurv.)		Resurv.
Original or Resurvey				
Appearance of B.T.		Good		Good
Tags, Marks, etc.				

Ray Kumpstern
Signed
for O.S.G.F.