

REM. T 32 S R 5 W COR. $\frac{26}{35} \frac{25}{36}$
SECS.

FD. LIVE OAK (NOW 12" DIAM.)

S 70° E 6 6 FT. - SCRIBING VISIBLE
ON PARTLY EXPOSED FACE.

FD. LIVE OAK (NOW 9" DIAM.)

S 75° W 14 5 FT. - FAINT SCARS
VISIBLE.

FD. LIVE OAK (NOW 12" DIAM.)

N 22° W 15 2 FT. - FAINT SCARS VISIBLE.

FD. LIVE OAK (NOW 20" DIAM.)

N 30° E 21 8 FT. - FAINT SCARS VISIBLE
ALL DISTANCES ARE SLOPE DIST.

AT COR. SET $\frac{3}{4}$ " IRON ROD.

NO COR. MONUMENT FD.

BLAZE & RESCRIBE!

20" LIVE OAK N 30° E 21 8 FT.

(SLOPE DIST.) MKD. "S 25 CS BT"

9" LIVE OAK S 75° W 14 5 FT.

(SLOPE DIST.) MKD. "S 35 CS BT"

12" LIVE OAK N 22° W 15 2 FT.

(SLOPE DIST.) MKD. "S 26 CS BT"

DID NOT RESCRIBE S. E. TREE.

COR. LIES ON VERY STEEP S. W.

SLOPE.

JUNE 24, 1964

Milo E. Gregory

M.G.

M.S.

1A ✓ ○

C. S. File No.

53/52-41


REN, JUNE 24, 1964

Wils. C. Godfrey

Section 26/25
35/36

Twp 32S Rge 5W W

Date: 9/25/58

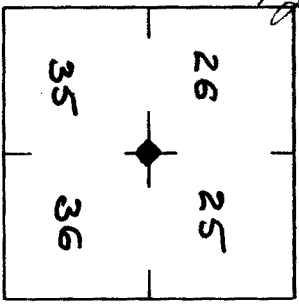

How was corner identified? Corner not in

place.

Condition of corner: 4 B.T.S

Best route to reach corner: _____

Other Remarks:

Quadrant	NE	NW	SE	SW
Species & Size	16" Live Oak	18" Live Oak	12" Live Oak	10" Live Oak
Dist. & Bearing	38 LWS N30°E	23 LWS N22°W	10 LWS S70°E	22 LWS S75°W
Condition of Scribe	O	Closed	Closed	Closed
Original or Re-survey	Orig.	Orig.	Orig.	Orig.
Appearance of B.T.	Good	Good	Good	Good
Tags, Measurements, etc.	OS&F	—	—	—

Doug Emery
For OS&F SIGNED