

REN. T 32 & 33 S R 5 W COR. SECS. $\frac{36}{1}$

(ON W. LINE SEC. 31 T 32 S R 4 W)

FD. DOUG. FIR (NOW 24" DIAM.)

S 60° W 11 $\frac{1}{2}$ FT. - SCRIBING VISIBLE
ON PARTLY EXPOSED FACE "R 5 W" -
TREE ALIVE & IN GOOD CONDITION.

FD. DOUG. FIR (NOW 23" DIAM.)

N 62° W 13 $\frac{1}{2}$ FT. - PREVIOUSLY OPENED,
BUT NEARLY HEALED OVER - NO SCRIBING
VISIBLE - TREE IN GOOD CONDITION.

FD. DOUG. FIR (NOW 26" DIAM.)

N 42° E 21 $\frac{1}{8}$ FT. (NOT 17 $\frac{1}{8}$ FT.) -
SCRIBING VISIBLE ON PARTIALLY EXPOSED
FACE "S 31" - TREE IN GOOD CONDITION.

FD. PARTLY ROTTEN CEDAR STUMP

S 58° E 25 $\frac{1}{2}$ FT. - SCRIBING VISIBLE
"R 4 W T 33 S 5 6"

AT COR. SET IRON PIPE WITH BRASS
CAP MKD. "COUNTY SURVEYOR'S OFFICE

1964 T 32 S R "

R	536	S	4
5	81	31	W
W			

T 33 S

DID NOT MARK ANY NEW TREES.

JUNE 29, 1964

M. S.
W. S.
M. D.
M. S.


Milo C. Godfrey

✓✓✓
+ X

C. S. File No. 53/52-62

COR. FDR SECS 36 & 1 ONLY
 T 32+33S R 5 W.
 RENEWED JUNE 29, 1964

Section 36 & 1 Twp 32+33S Rge 5 W
 Date: 12/11/58

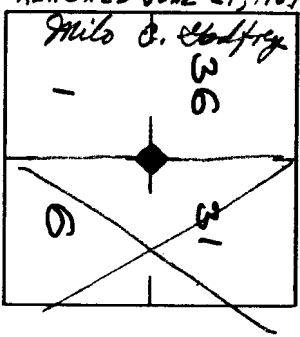

How was corner identified? Post 1'x1'x18"
 Condition of corner: Good
 Best route to reach corner: _____

Quadrant	NE	NW	SE	SW
Species & Size	DF 24"	DF 22"	40' Cedar stump	DF 19"
Dist. & Bearing	N40°E 21'	N65°W 14'	S65°E 22'	S50°W 11'
Condition of Scribe	Good	Closed	Good	Good
Original or Resurvey	Resurvey	Resurvey	Resurvey	Resurvey
Appearance of B.T.	T 331	Good	T 333	RSW
Tags, Nails, etc.	-	-	-	-

Other Remarks:

Bob Baker

Signed