

REN.

T 32 S R 4 W

S.W. COR.

SEC. 31

(ON E. & N. LINES OF SEC. 1 T 33 S R 5 W)

FD. DOUG. FIR (NOW 21" DIAM.) N 47° E


21 1/2 FT. - FRAGMENTARY SCRIBING

VISIBLE ON PARTIALLY ROTTED FACE.

DID NOT FIND MARKED ROCK AT

COR.

AT COR. SET IRON PIPE WITH BRASS CAP MKD. "COUNTY SURVEYOR'S OFFICE 1964

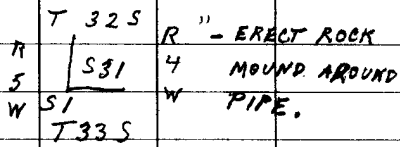

BLAZE & RE SCRIBE:

21" DOUG. FIR N 47° E 21 1/2 FT.

MKD. "T 32 S R 4 W S 31 CS BT"

BLAZE & SCRIBE:

9" DOUG. FIR S 44° E 11 1/2 FT.

MKD "T 33 S R 5 W S 1 CS BT"

COR. LIES ON VERY ROCKY, VERY STEEP, N.W. SLOPE.

JUNE 29, 1964

M.G.
W.S.
M.D.
M.S.

Milo C. Godfrey

C.S. File No. 53/52⁶⁶

SEE OVER

✓✓✓
+X○○

CORNER SEARCHED FOR
& NOT FD.

STANDARD CORNER - ON TOWNSHIP LINE
FOR T32S, R6 44E W - (NOW A.P.)
COR. SET BY MCKENZIE & ECKLESON, 1879

536 | 531 - NO TRACE FOUND.

FILED
RECEIVED

JUN 29 1964

COUNTY SURVEYOR
DOUGLAS COUNTY, ORE.

ORIEISEN NO. 285-6