

Sec. Cor. of $\frac{2}{11} \frac{1}{12}$ T30S R9W ^{Renewal #11}

Fd. BRASS cap & I.P. in Good Cond-
ition - All ORIGINAL B.T.'s completely
destroyed by FIRE. Renewal
B.T.'s, mKd in 1958 Dead & Scribe
Burned off all except -

44" D. FIR N. 85° E. 18° ft. &

5" CEDAR N. 14° W. 31° ft.

New B.T.:


9" CEDAR N. 37½° W. 184° ft.

MKd T30S R9W S 2 CS B.T.


This COR. lies on S.W. Slope
approx. 100° ft. above small creek.

V. R. Tracy
M. Darby

V. R. Tracy

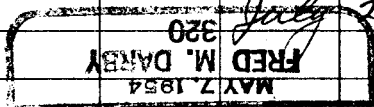

Fred M. Darby

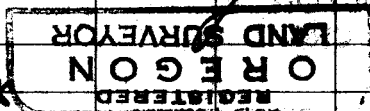

C. S. File No. 53/53-8