
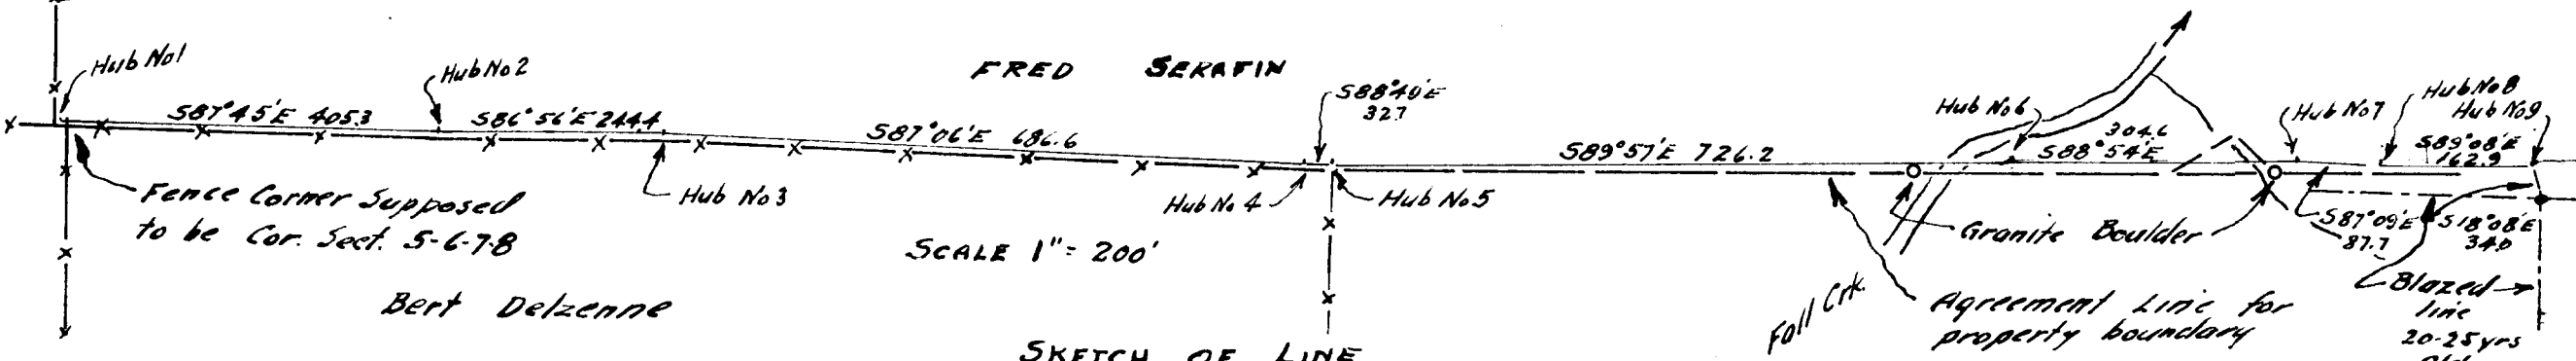


ENLARGED SECTION ACROSS BOTTOM

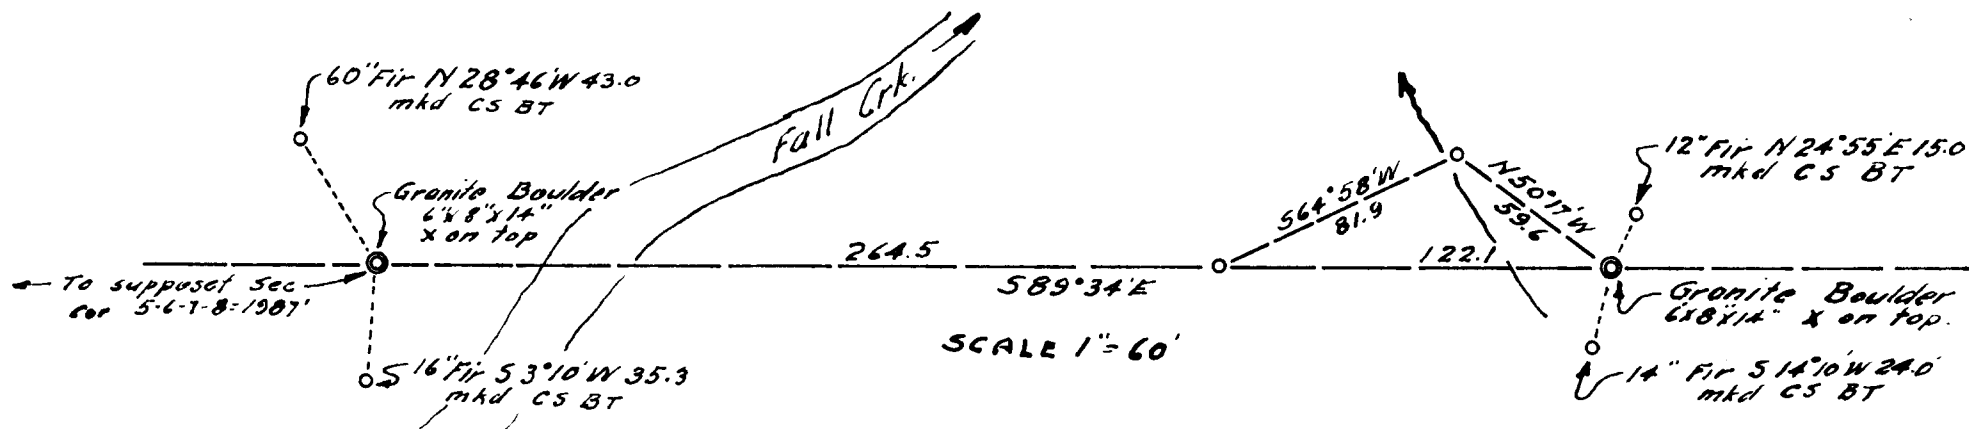

SKETCH OF LINE
BETWEEN
SEC. 5 and 8, T 27 S R 3 W
showing
AGREEMENT LINE FOR PROPERTY
BOUNDARY.

Ben. B. Irving Dep. Co. Surv.
March 13, 1934

COUNTY SURVEYORS FILE DATA
DO NOT REMOVE FROM OFFICE

CS FILE FOLDER

CONTAINS

MORE

INFORMATION