

11/12
14/13

Renewal

T195 R10W

Fork
Wider cor Tree NW stump scribe visible
S13
Pine Iron Wall point along side stump
26" D. Fir new stump N 33 1/2 E cor
same scribe marks visible mostly
grown over.


Possible orig. Fir 14" NW 76"
S 28 E S 73 shows Foot
scr. I do not open because cor is
in clear cut unit. with no heavy
trees available.

Renewal

Set Brass cap along side wall point
also cor stump. WAD,

county Surveyors office


T195 R10W

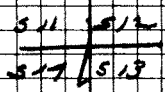

1971

Steel Fence Post along side Brass cap
New Bearing Stump & objects

32" D. Fir stump S 6 W S 8 E
scribed T195 R10W S14 at 27

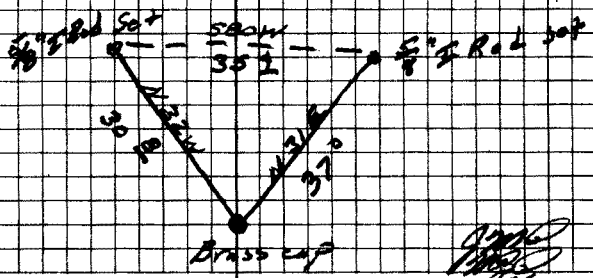

Brass cap

[Handwritten signature]

#13

C.S. File No. 53/66-4A

DIETZGEN NO. 385-6