

Renew  $\frac{1}{4}$   $\frac{53}{510}$  T305 RBW

Fd. Orig. 5" now 12" Yew N. 10° E. 19 $\frac{1}{2}$  Ft.

Very old face apparently never healed  
shows poor  $\frac{1}{4}$ " scribe-lower face

very badly rotted. B.T. alive in poor cond.

Fd. Orig. 12" now 17" cedar (smag) S. 12° W. 13 $\frac{1}{2}$  Ft.

Burned face - No scribe found. We

set 1" I.P. & BRASS CAP MKD. "COUNTY  
SURVEYOR'S OFFICE 1965 T305

$\frac{1}{4}$   $\frac{53}{510}$  RBW." & MK. New B.T.' -

8" D. FIR S. 39° W. 23 $\frac{3}{4}$  Ft.

Mkd.  $\frac{1}{4}$  510 CS BT"


9" Hemlock N. 32° E. 40 $\frac{1}{2}$  Ft.

Mkd.  $\frac{1}{4}$  53 CS BT"

This cor. Lies approx 300 ft West.  
of creek flowing N.E.

OCT. 12, 1965

V.R.T.  
M.S.  
J.L.

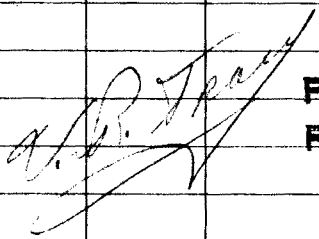

FILED  
RECEIVED

OCT 12 1965

COUNTY SURVEYOR  
DOUGLAS COUNTY, ORE.

C. S. File No. 53/67-30

0279  
+279