

516 | 515  
Reven Sec. Cor. 521 | 522 T305 R8W

Ed. FOUR ORIGINAL B.T.'S 2<sup>nd</sup> COR. 25 follows -

24" Now 32" Pine N. 50° E. 6<sup>6</sup>/<sub>16</sub> ft.

Sign of faint SCAR.

10" Now 12" Pine (SNAG) S. 70° E. 7<sup>9</sup>/<sub>16</sub> ft.

Recorded S. 60° E. - open & shows "T 3 S

BT"

10" Now 12" Laurel S. 64° W. 20<sup>5</sup>/<sub>16</sub> ft.

Shows Good SCAR & "T 5" on face.

14" Now 26" Pine N. 24° W. 26<sup>4</sup>/<sub>16</sub> ft.

Shows "R" scribe on face. Set 1" I.P.

& BRASS CAP MKD. "COUNTY SURVEYOR'S

OFFICE 1965 T305 R8W 

516	515
521	522

"

WE MARK ONE NEW BT & RESCRIBE ONE

OLD BT. 25 follows -

32" PINE (ORIG). N. 50° E. 6<sup>6</sup>/<sub>16</sub> ft.

MKD. "T305 R8W S 15 CS BT"

12" D. FIR S. 45° E. 21<sup>2</sup>/<sub>16</sub> ft.


MKD. "T305 R8W S 22 CS BT"

April 8, 1965

V.R.T.

M.D.

J.B.

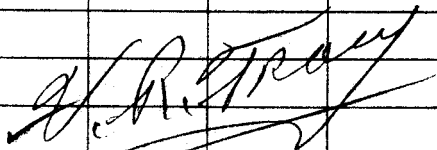

+ \*  
O 56

C.S. File No.

53/67-33