

Renew $\frac{1}{4}$ $\frac{59}{516}$ T305 R8W

Ed. at cor. cedar stub N. 28°W, 11 1/2 ft.

No scribe & 40" was 36" cedar

laying in creek Bottom shows

partial scribe & axe marks on

what is left of overgrowth. This

tree fell & slid into creek - There

is a hole S. 68°W, approx. 30 ft.

set for cor. a 1" I.P. & Brass cap

Mkd. "COUNTY SURVEYOR'S OFFICE 1964

T305 R8W $\frac{1}{4}$ $\frac{59}{516}$ " & Mkd. New BTs -

20" cedar N. 11°W. 41 1/2 ft.

Mkd "1/4 59 CS BT"

40" cedar S. 85°E 26 1/2 ft.

Mkd "1/4 516 CS BT"

This cor. lies on the West

side of small creek 7° ft East.

FILED

RECEIVED

Sept. 15, 1964

VRT.
M.D.
J.B.

SEP 16 1964


COUNTY SURVEYOR
DOUGLAS COUNTY, ORE.

C. S. File No.

63/62

Section 9 Twp 30 Rge 8 W 531-64

How was corner identified? By ORIG B.T.

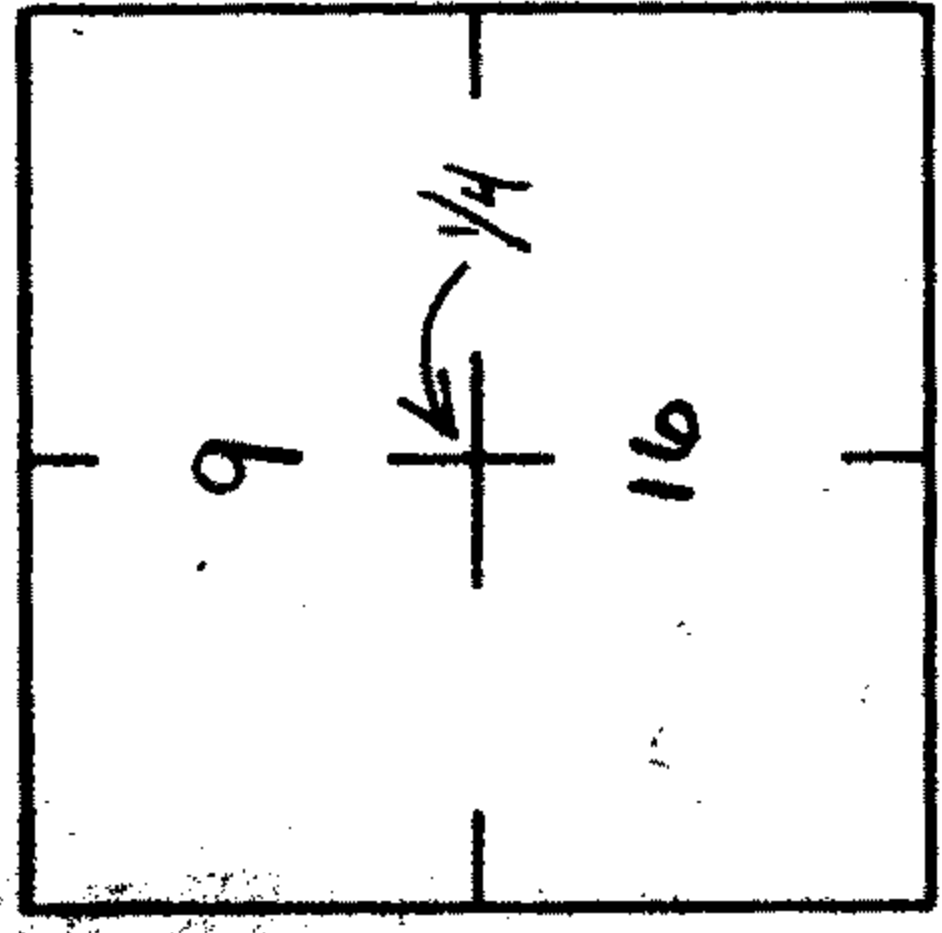

Condition of corner: Poor

Best route to reach corner: UP BUCK SPRINGS ROAD

Other Remarks:

Revised
9/15/64
[Signature]
Henry Johnson

Quadrant	NE	NW	SE	SW
Species & Size				CEDAR 36"
Dist. & Bearing				S 65W 46 LNS
Condition of Scribe				Poor
Original or Resurvey				ORIG
Appearance of B.T.				DOWN
Tree marks, etc.				TAG

Signed

CS 53/67-87