

Renew  $\frac{1}{4} \frac{510}{515}$  T305 R8W

Fd. at Cor. 2" x 2" x 4' Squared Post. &

14" New 24" Laurel "North" 16<sup>S</sup> ft.

Shows faint "T" scribe. The 10"

Laurel S, 54° W. 15<sup>E</sup> ft. is down and

mostly rotted away. Fd. "2" Reverse scribe.

Set at Cor. 1" IR & Brass cap mkd.

"COUNTY SURVEYOR'S OFFICE 1964

T305 R8W  $\frac{1}{4} \frac{510}{515}$  " & New BT's

6" D. FIR N, 16° W. 38<sup>1/2</sup> ft.

Mkd "  $\frac{1}{4} 510$  CS BT "

16" D. FIR S. 39° E. 17<sup>S</sup> ft.

Mkd. "  $\frac{1}{4} 515$  CS BT "

Sept. 15, 1964

V.R.T.

M.D.

J.B.

V.R.T. Tracy

FILED

RECEIVED


SEP 16 1964

COUNTY SURVEYOR  
DOUGLAS COUNTY, ORE.

+ X/O  
C.S. File No.

52/67-5

Station 15 TRP 305 SW 8W Date: 8/31/64

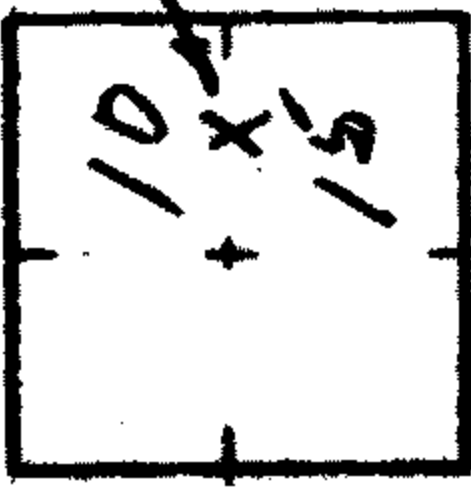

How was corner identified?

Two laurel B.T.S  
correct dist. size & bear - one dead

Condition of corner:

Foot

Cutting to progress soon

Best route to reach corner:

Burma road to  
crossing tag - check route through clearcut.

M. W. Taylor

Other Remarks:

Quadrant	NS	WN	ES	SE
Species & Size	Laurel 24"			Laurel 10"
Diam. & Bearing	N 25 W 1/4			S 54 W 2 1/4
Condition of Scribe	None	cotton spec		None
Condition of Boundary	Original			Original
Condition of B.T.	Foot			Dead
Station	15			15

Reviewed  
9/15

exp marks

85-24/67-58