


COUNTY SURVEYORS FILE DATA
 DO NOT REMOVE FROM OFFICE
 HATCHERY SITE
 OREGON FISH COMMISSION
 CALAPOOYA CREEK
 SEC. 10. T.25S., R.4W., W.M.

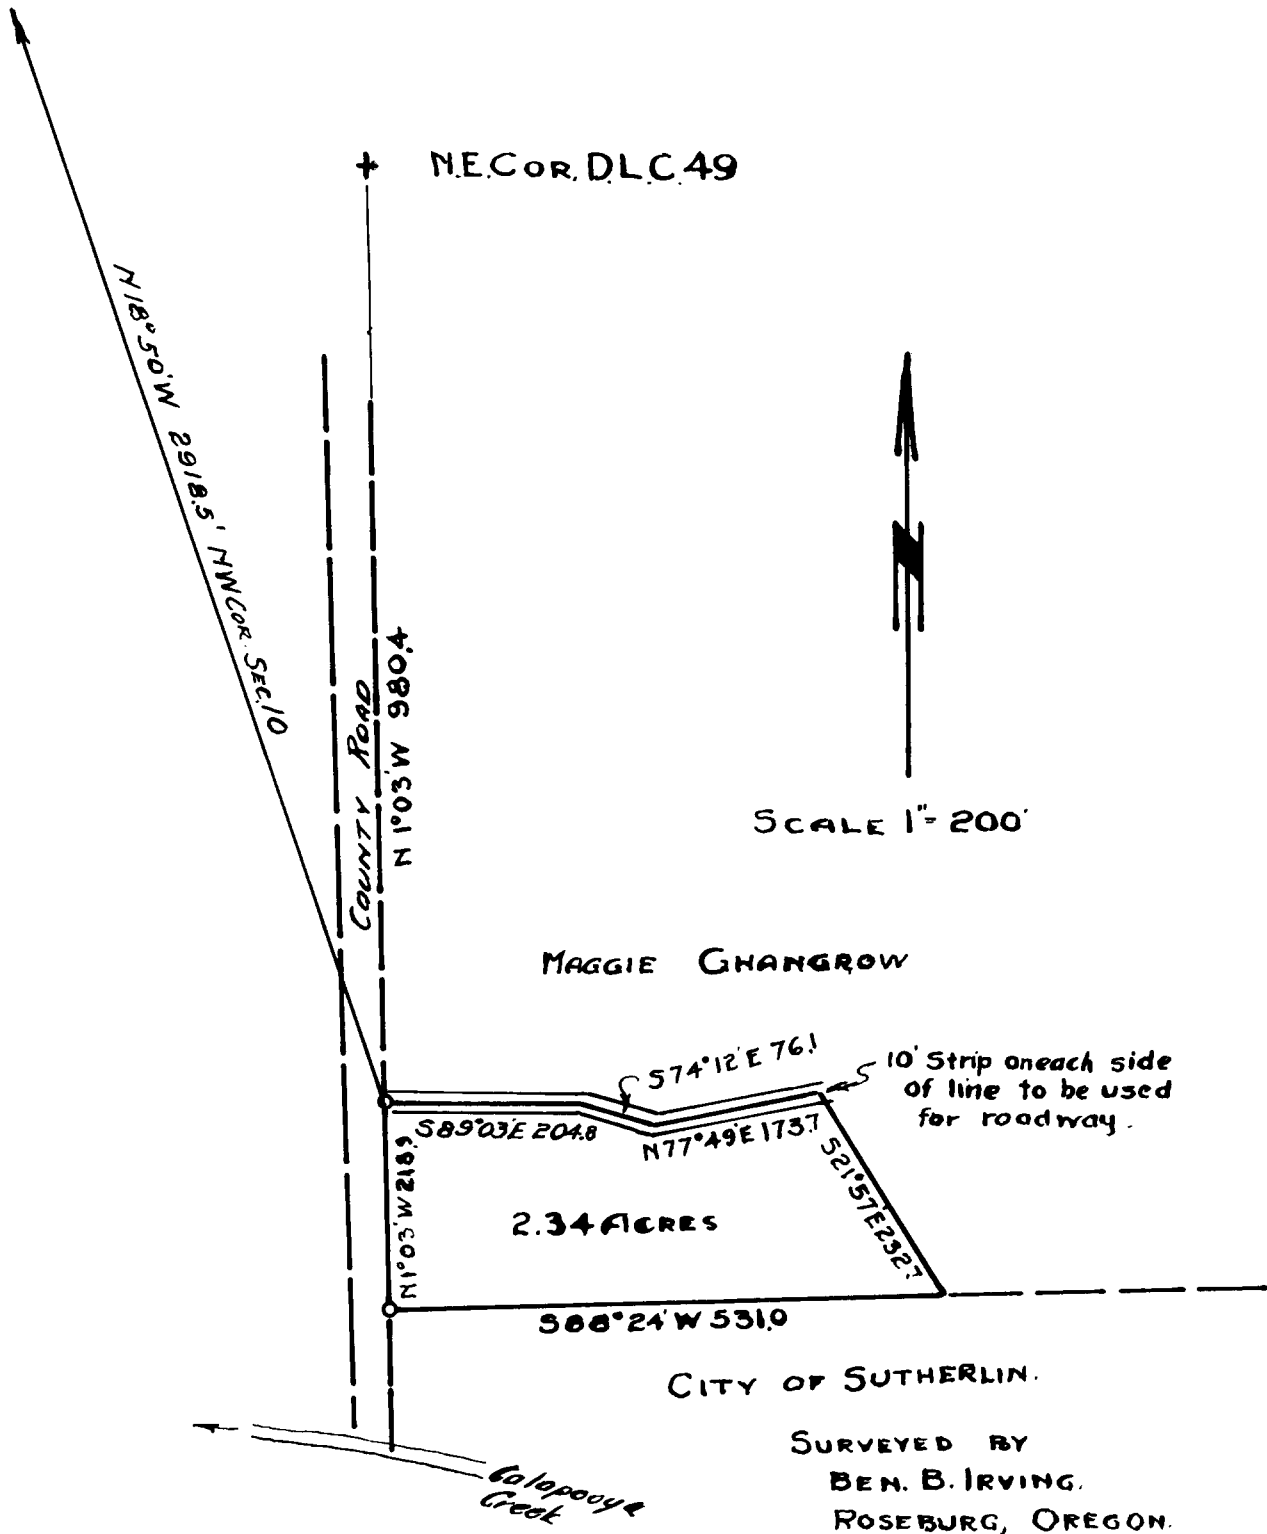

CS FILE FOLDER

CONTAINS

MORE

INFORMATION