

REN. T 23 S R 9 W

COR. SECS.

22	23
27	26

FD. FIR TREE (NOW 42" DIAM.)

N 52° W 66 FT. - PREVIOUSLY
OPENED. - GOOD SCRIBING "S 22" VIS-
IBLE ON OLD FACE,

FD. RED CEDAR (NOW 48" DIAM.)

N 2½° E 46½ FT. - OLD FACE APP-
ARENTLY ROTTED AWAY.

FD. DEAD FIR SNAG S 32° W

33½ FT. - NO SCARS OR OLD FACE
VISIBLE.

THE S.E. TREE IS UPROOTED AND
HAS SLID DOWNHILL FROM WHERE
IT STOOD. - LARGE STUMP HOLE VISIBLE.

AT COR. SET IRON PIPE WITH
BRASS CAP MKD. "COUNTY SURVEYOR'S
OFFICE 1964 T 23 S R 9 W

S 22	S 23
S 27	S 26

"

BLAZE & SCRIBE!

7" HEMLOCK S 84° W 25³/₄ FT.

MKD. "T 23 S R 9 W S 27 C.S. BT"

9" HEMLOCK S 76° E 26²/₄ FT.

MKD. "T 23 S R 9 W S 26 C.S. BT"

THE NE & NW ORIG. B.T.'S ARE
STILL ALIVE & IN GOOD CONDITION
OCT. 19, 1964

Miles E. Goffrey

M.G.

W.S.

M.S.


○ 7-C

+ X ✓

C.S. File No. 53/84-3

(2)

Section 23 Twp 23S Rge 9 W 1 Date: June 29, 1964

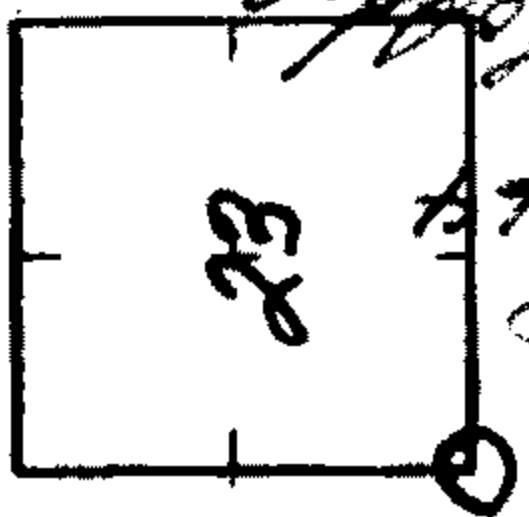

How was corner identified? 3 B.T.S. / windthrow

Condition of corner: Stake in mound of rocks

Adjacent land private.

Soup Creek jeep road, same as quarter corner.

Best route to reach corner:

600' left of jeep road.

Other Remarks:

Quadrant	NE	NW	SE	SW
Species & Size		D.F.	D.F.	D.F.
Dist. & Bearing				
Condition of Scribe				
Original or Resurvey				
Appearance of B.T.				
Tags, Marks, etc.	CS	53/84-3		

Karl F. Lanning
BLM Case # Signed