


SPRINGFIELD SURVEY FILE

PUBLIC LAND CORNERS

WEYERHAEUSER COMPANY
SPRINGFIELD BRANCH

TOWNSHIP 20 S RANGE 6 W
SECTION 22 CORNER S 1/4
COUNTY Lane & Douglas OREGON

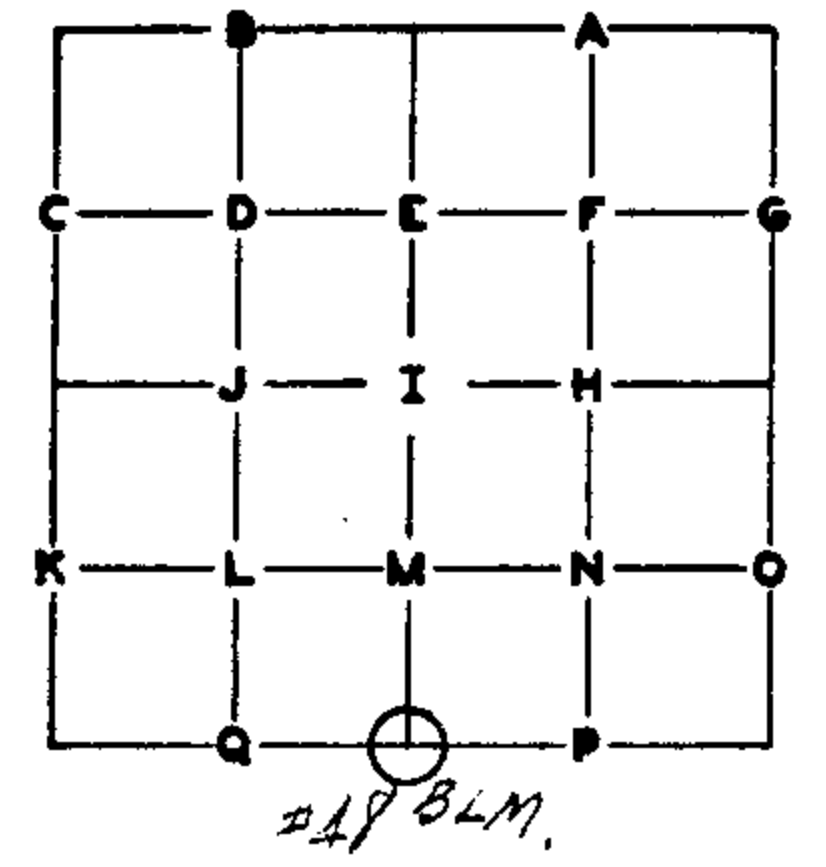

GLO SURVEY RECORD		PRESENT CONDITION - (DESCRIBE FULLY - USE PAGE 2 IF NEEDED FOR EXPLANATION.)	
DATE: 1950		Found as described by G.L.O.	
CORNER Brass Cap			
ACCESSORIES:			
	BEARING-	LINKS-	FEET-
32" Hem	N 7 1/2° W	82	54.1
40" Cedar	S 44 1/2° W	9	5.9
			Good condition
			" "
SURVEY RECORD		PRESENT CONDITION:	
DATE:			

CORNER SET: ----- MAG. DECL.: 20°

BEARING AND DISTANCE TO ABOVE IDENTIFIED SURVEY ACCESSORIES:			
BEARING-	FEET-	SURVEY -	
N 8° W	54.2	1950	Measured to center of tree
S 44° W	5.0	1950	" " face of tree; face is on NW lobe of BT by McClung in 1872 GLO survey

ACCESSORIES ADDED THIS DATE:

MAGNETIC DECLINATION 20°

	BEARING	FEET	ORIG. B.T.	"W" NAIL	PLATE	BRASS DISC
40" Cedar	S 44° W	5.0	X	X	X	--
44" Cedar	N 56° E	37.5	--	X	X	--

IDENTIFIED ON PHOTO:

INFORMATION ON LOCATION OF CORNER AS NOW SET:

GROUND COVER: Sword fern and vine maple
(USING FORM LINES SKETCH TOPOG AT CORNER ON PAGE 2 PLAT)
SLOPE FACES (GIVE BEARING IN DEGREES) S 85° W ON MINUS (-) 4% (down Creek)

NORTH: 30' @ 0%; thence + 60%; logged 8 to 10 years.
N 45° W 8' to center line of Beaver Creek, bearing S 85° W & N 56° E

SOUTH: + 80%; uncut Old Growth fir

EAST: + 50%

WEST: + 15%

WORK DONE FOR W. CO.

FIELD NOTES IN BOOK: _____

BY: William H. Pitt DATE: 6/19/61
ENGINEER SURVEYOR
Land Agent

ASSISTED BY: (none)

COPIES SENT TO: _____

UNDER THE SUPERVISION OF:

CS 53/102-1