


# PUBLIC LAND CORNERS

T 20-9

WEYERHAEUSER TIMBER COMPANY  
 SPRINGFIELD BRANCH

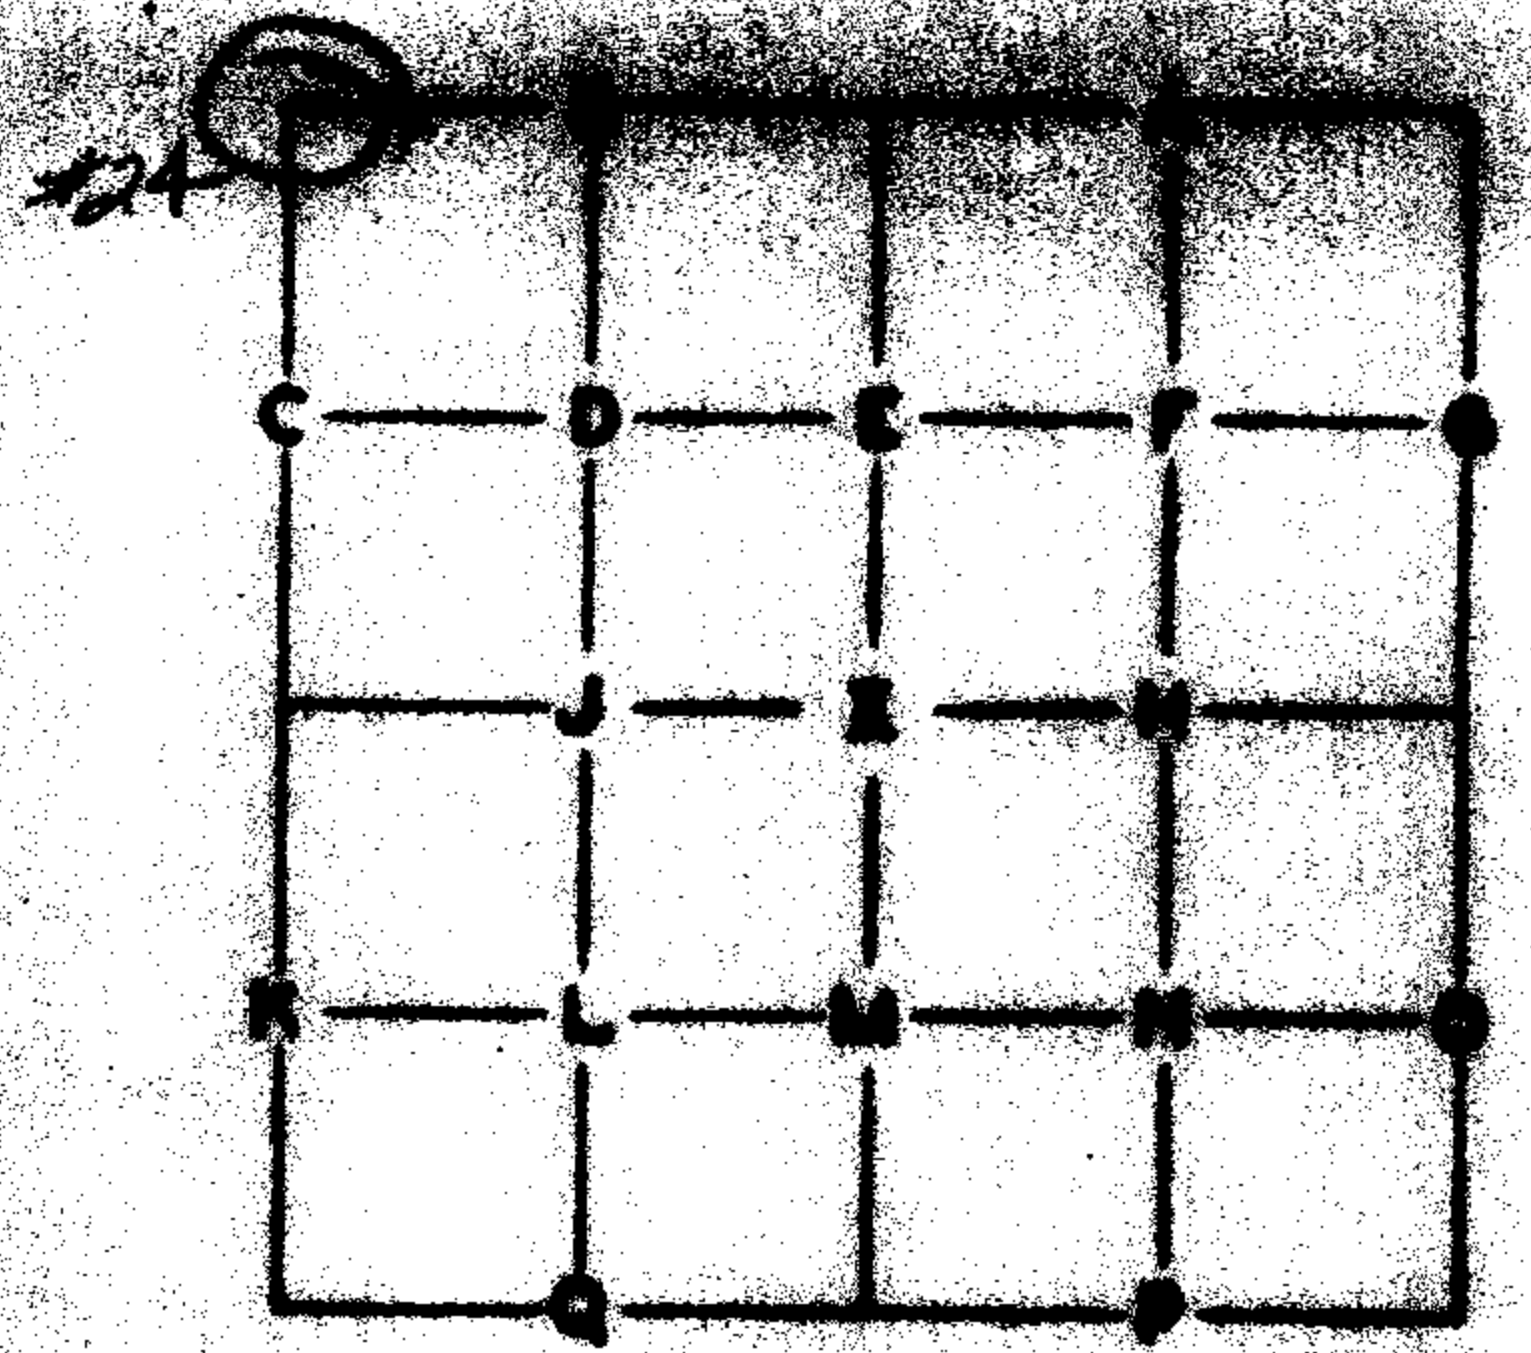

TOWNSHIP \_\_\_\_\_ RANGE \_\_\_\_\_  
 SECTION 16 CORNER \_\_\_\_\_  
 COUNTY TOLLESON OREGON

## GLO SURVEY RECORD

PRESENT CONDITION - (DESCRIBE FULLY)

CORNER POST DATE: 1872

### ACCESSORIES:

	BEARING-	LINKS-	REMARKS	
1" FIB	N 2° W	40		NO REMAINING EVIDENCE
8" FIB	S 88° W	44		NOW A 1" BLOWDOWN - SOME POINT ON FACE - EVIDENCE HAS BEEN CHIPPED OUT
2 1/2" FIB	N 55° E	50		NO REMAINING EVIDENCE
1 1/2" FIB	S 40° E	20		NOW AN 1 1/2" DIA SWAC - FACE IS CHIPPED OFF - EVIDENCE BEING PLAINLY VISIBLE

SURVEY RECORD DATE:

PRESENT CONDITION:

CORNER SET: 3/4" PIPE MAGNETIC DECLINATION: 20°

### BEARING AND DISTANCE TO ABOVE IDENTIFIED SURVEY ACCESSORIES:

BEARING-	FEET-	REMARKS
S 88° W	37.0'	ORIGINAL BT - BLOWN DOWN - EVIDENCE ON FACE
S 40° E	13.6'	ORIGINAL BT - 1 1/2" DIA SWAC - SCREWMARK VISIBLE

CS 53/162-8

8

ACCESSORIES ADDED THIS DATE:

	BEARING -	FEET -	"W" NAIL -	PLATE -	BRASS DISC -
3" FIR STUMP			X	✓	
3" FIR NAIL			X	✓	
4" FIR			X	✓	
2" FIR			X	✓	

IDENTIFIED ON PHOTO:

INFORMATION ON LOCATION OF CORNER AS NOW SET:

DESCRIPTION OF GROUND COVER AND GROUND SLOPE AT CORNER: \_\_\_\_\_

FROM CORNER NORTH: \_\_\_\_\_

SOUTH: \_\_\_\_\_

EAST: \_\_\_\_\_

WEST: \_\_\_\_\_

WORK DONE FOR W. T. CO.

BY: Boustead  
ENGINEER - SURVEYOR

DATE: AUG. 51

ASSISTED BY: \_\_\_\_\_

UNDER SUPERVISION OF:

COPIES SENT TO: \_\_\_\_\_

SEAL