


PUBLIC LAND CORNERS

SPRINGFIELD
SURVEY FILE

WEYERHAEUSER TIMBER COMPANY
 SPRINGFIELD BRANCH

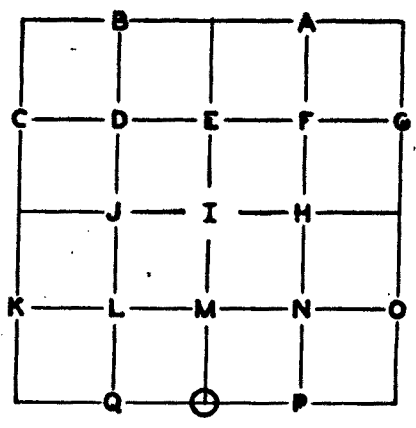

TOWNSHIP 20 S RANGE 4 W
 SECTION 31 CORNER S 1/4
 COUNTY Lane OREGON

GLO SURVEY RECORD	PRESENT CONDITION - (DESCRIBE FULLY - USE PAGE 2 IF NEEDED FOR EXPLANATION.)																																													
DATE: <u>1854</u>																																														
CORNER <u>Post</u>																																														
ACCESSORIES:																																														
<table border="1" style="width: 100%; border-collapse: collapse;"> <thead> <tr> <th style="width: 15%;"></th> <th style="width: 15%;">BEARING-</th> <th style="width: 15%;">LINKS-</th> <th style="width: 15%;">FEET-</th> <th style="width: 40%;"></th> </tr> </thead> <tbody> <tr> <td>30" R. fir</td> <td>N 61° W</td> <td>124</td> <td>81.8</td> <td>found - standing green-bark scribed</td> </tr> <tr> <td>4" " "</td> <td>S 7 1/2° W</td> <td>86</td> <td>56.8</td> <td>No trace</td> </tr> <tr><td> </td><td> </td><td> </td><td> </td><td> </td></tr> <tr><td> </td><td> </td><td> </td><td> </td><td> </td></tr> <tr><td> </td><td> </td><td> </td><td> </td><td> </td></tr> <tr><td> </td><td> </td><td> </td><td> </td><td> </td></tr> <tr><td> </td><td> </td><td> </td><td> </td><td> </td></tr> <tr><td> </td><td> </td><td> </td><td> </td><td> </td></tr> </tbody> </table>		BEARING-	LINKS-	FEET-		30" R. fir	N 61° W	124	81.8	found - standing green-bark scribed	4" " "	S 7 1/2° W	86	56.8	No trace																															
	BEARING-	LINKS-	FEET-																																											
30" R. fir	N 61° W	124	81.8	found - standing green-bark scribed																																										
4" " "	S 7 1/2° W	86	56.8	No trace																																										
No record																																														
SURVEY RECORD	PRESENT CONDITION:																																													
DATE: _____																																														
fd. 1/2" iron pipe at record bearing and distance from BT in Section 31-20-4W																																														

CORNER SET: 1/2" iron pipe MAG. DECL.: 20°

Record bearing and distance from face of BT in Section 31

BEARING AND DISTANCE TO ABOVE IDENTIFIED SURVEY ACCESSORIES:

BEARING -	FEET -	SURVEY -	
N 61° W	8181.8	GLO	30" Fir

CS 53 / 103

ACCESSORIES ADDED THIS DATE:

MAGNETIC DECLINATION 20°

	BEARING	FEET	ORIG. B.T.	'W' NAIL	PLATE	BRASS DISC
16" D. fir	N 13° E	13.3		X	X	4113
42" " "	S 36° W	51.8		X	X	"

IDENTIFIED ON PHOTO: NO

INFORMATION ON LOCATION OF CORNER AS NOW SET:

GROUND COVER: Second growth

(USING FORM LINES SKETCH TOPOG AT CORNER ON PAGE 2 PLAT)

SLOPE FACES (GIVE BEARING IN DEGREES) N 68° E ON MINUS (-) 22 %

NORTH: -10% second growth

SOUTH: +7% 18' to gravel road - cutting line, green on the west, cut over on the East.

EAST: -14% - logged

WEST: +10% - 50' to gravel road - second growth

FROM CORNER -

WORK DONE FOR W. T. CO.:


FIELD NOTES IN BOOK:

BY: Douglas G. Calder DATE: 12/18/58
ENGINEER - ~~SURVEYOR~~

ASSISTED BY: Bob Barta

COPIES SENT TO:

UNDER THE SUPERVISION OF:

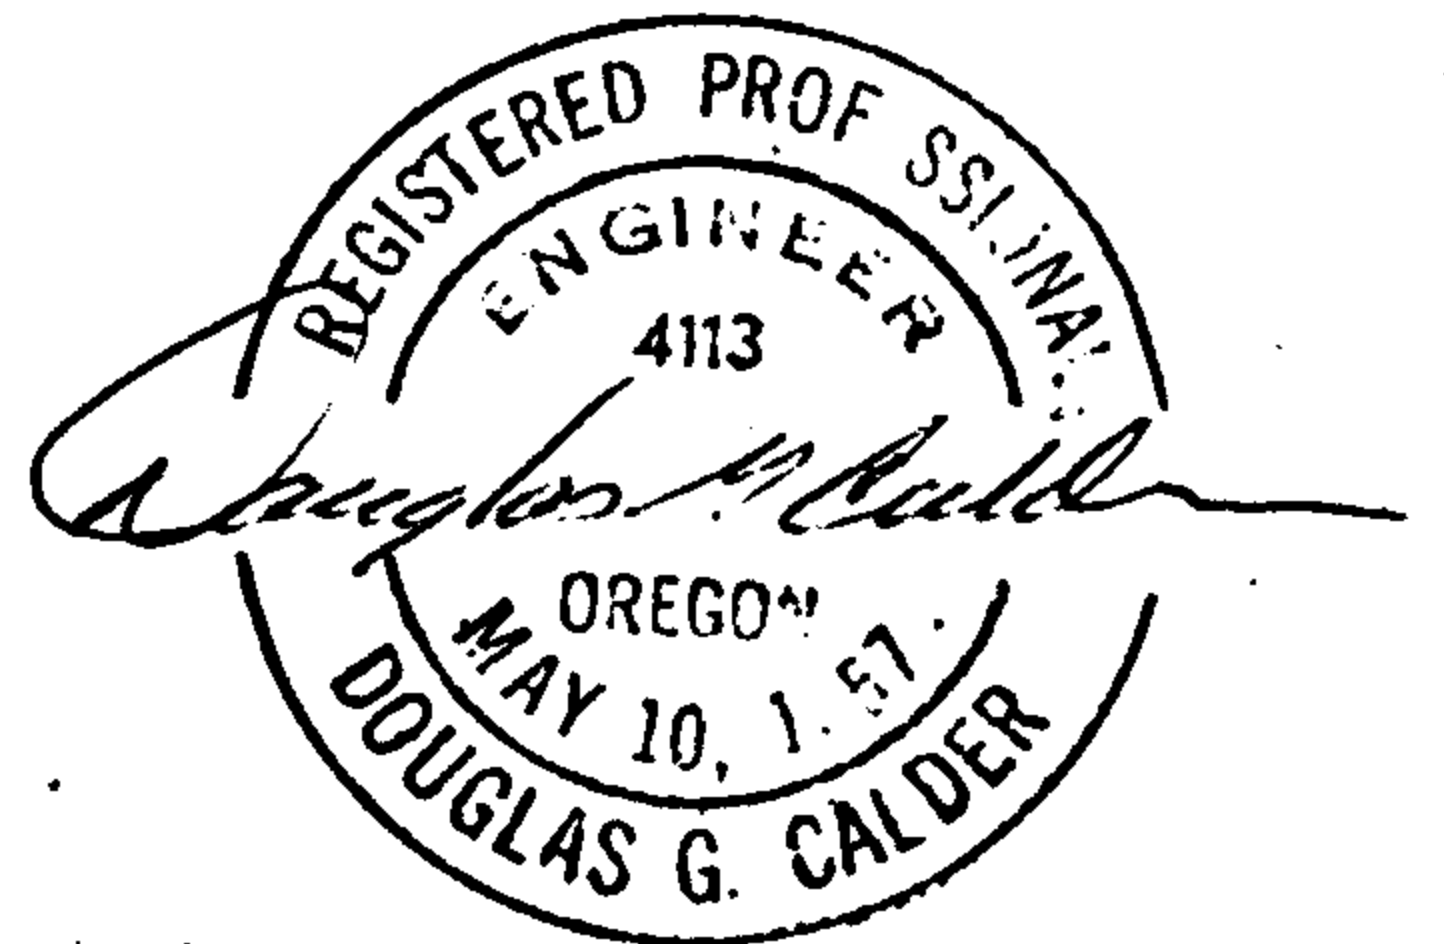

SEAL

