


PUBLIC LAND CORNERS

WEYERHAEUSER TIMBER COMPANY
SPRINGFIELD BRANCH

TOWNSHIP 215 RANGE 4W

SECTION 34 CORNER E 1/4

COUNTY Douglas OREGON

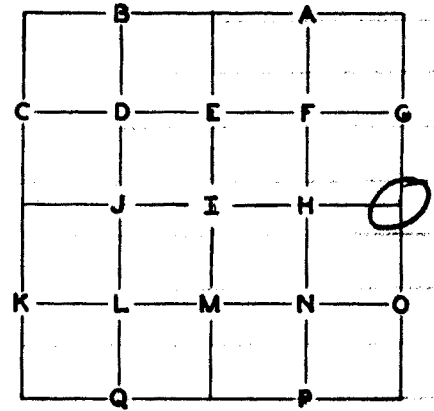

GLO SURVEY RECORD

CORNER Post DATE: 1855

PRESENT CONDITION - (DESCRIBE FULLY - USE PAGE 2 IF NEEDED FOR EXPLANATION.)

No Trace original

ACCESSORIES:

	BEARING-	LINKS-	FEET-
<u>10" Fir</u>	<u>N 40 E</u>	<u>25</u>	<u>16.5</u>
<u>8" Fir</u>	<u>S 87 W</u>	<u>12</u>	<u>7.9</u>

No Trace

Found 10" down stub - has been dead many years - scribing visible.

SURVEY RECORD
DATE:

N 30 W - 36.4'

Probably Douglas County

PRESENT CONDITION:

10" Fir scribed 1/4 S 34 CS BT about 6 months old.

CORNER SET: Found 1" iron rod.

MAG. DECL: 20°

BEARING AND DISTANCE TO ABOVE IDENTIFIED SURVEY ACCESSORIES:


BEARING-	FEET-	SURVEY -
<u>S 87 W</u>	<u>7.9</u>	<u>GLO</u>

10" Stub - down,

--- 1104 - 5


1A

SECTION 34 TOWNSHIP 21S RANGE 4W

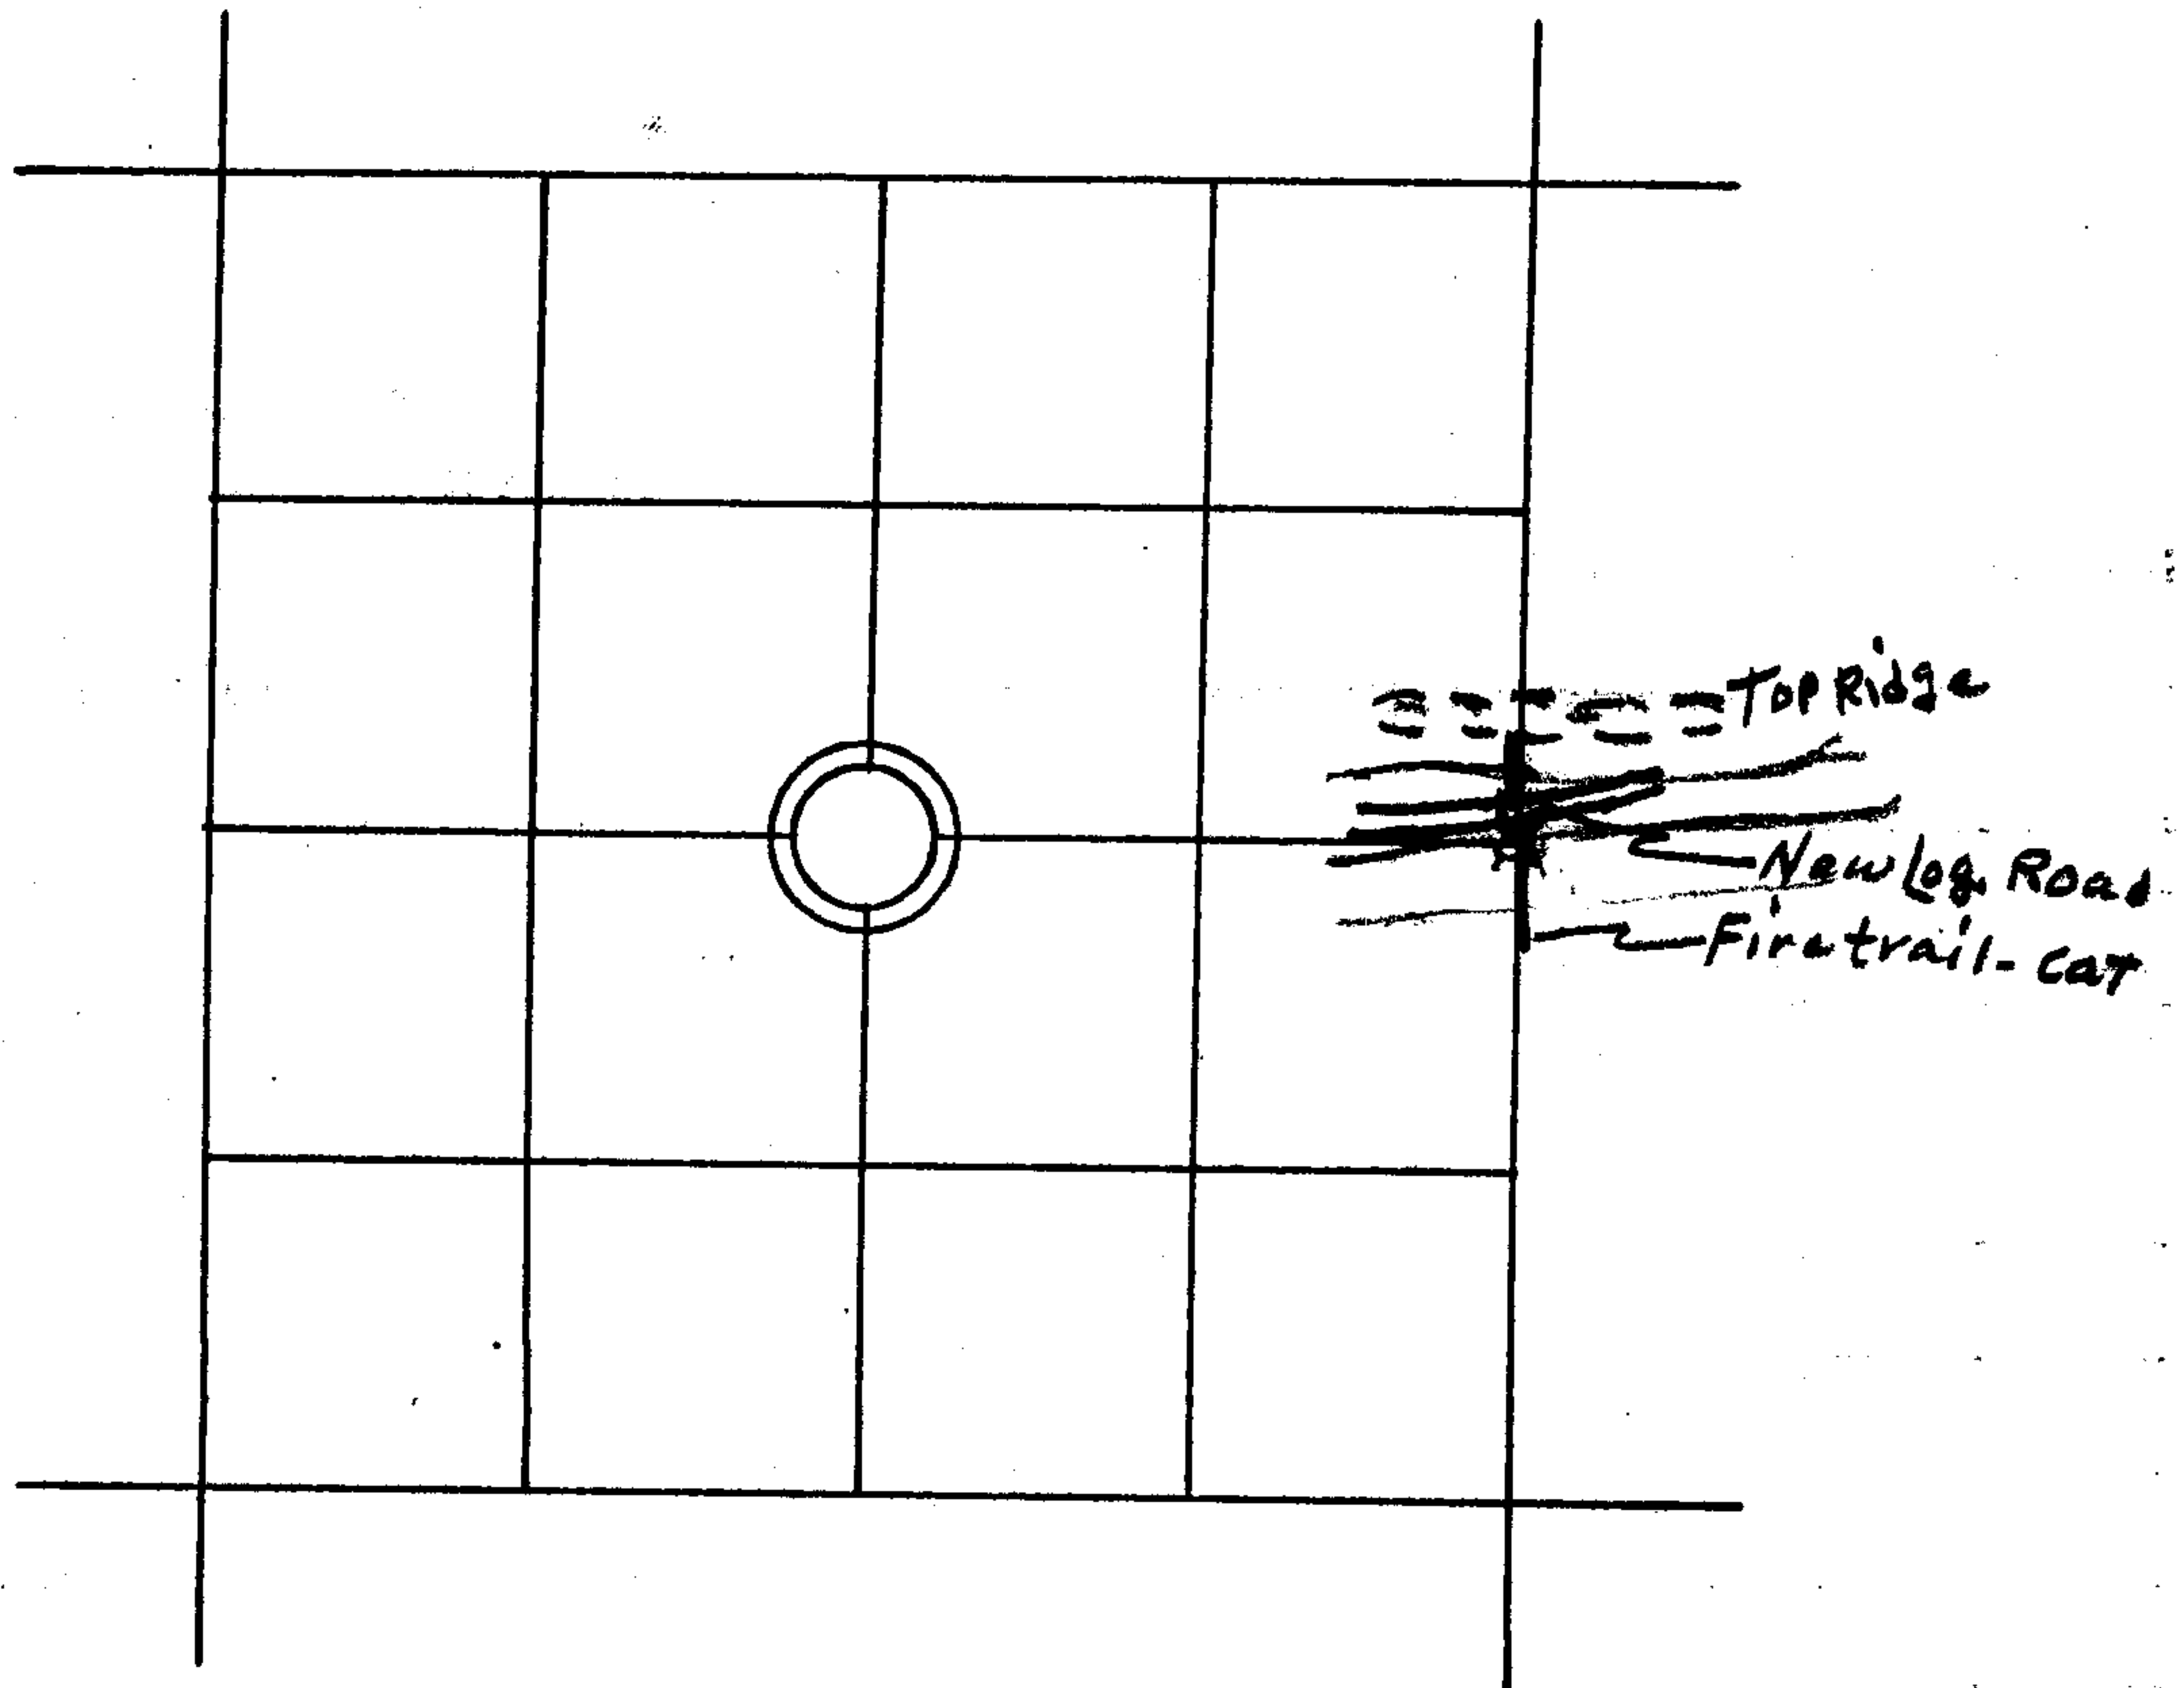

 LINE MARKED BY NOTCH CUT IN BLAZE.

 ...KNOWN CORNER.

 ...REFERENCED CORNER
BY WEYERHAEUSER
METHOD.

ACCESSORIES ADDED THIS DATE:

MAGNETIC DECLINATION 20°

	BEARING	FEET	CSBT B.T.	"W" NAIL	PLATE	BRASS DISC
10" Fir	N30W	36.4	CSBT	X	X	
36" White Fir	S75W	35.6		X	X	

IDENTIFIED ON PHOTO:

INFORMATION ON LOCATION OF CORNER AS NOW SET:

GROUND COVER: _____

(USING FORM LINES SKETCH TOPOG AT CORNER ON PAGE 2 PLAT)

SLOPE FACES (GIVE BEARING IN DEGREES) SIDE ON MINUS (-) 20 %

FROM CORNER -

NORTH: +25° 100' to newly constructed logging road, 1958 log, to East - 2nd growth and reprod. to West.

SOUTH: -20° Residual 2nd growth and reprod. to West, 1958 logging to take place.

EAST: -5°

WEST: +5°

WORK DONE FOR W. T. CO.:

FIELD NOTES IN BOOK: _____

BY: Glen McChesney
ENGINEER SURVEYOR

DATE: 4/30/58

UNDER THE SUPERVISION OF:

ASSISTED BY: _____

COPIES SENT TO: _____

SEAL