


PUBLIC LAND CORNERS

T 22-4

WEYERHAEUSER TIMBER COMPANY
 SPRINGFIELD BRANCH

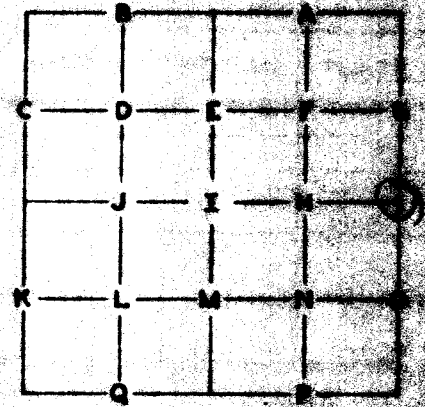

TOWNSHIP 22 S RANGE 14 W

SECTION 34 CORNER E

COUNTY DOUGLAS OREGON

GLO SURVEY RECORD

DATE: 1835

CORNER Post

PRESENT CONDITION - (DESCRIBE FULLY -
 USE PAGE 2 IF NEEDED FOR EXPLANATION)

No Trace Original

ACCESSORIES:

	BEARING-	LINKS-	FEET-	
50" Redwood	S 50° E	70	46.2	Not Redwood but Incense cedar. Upstate split and burned.
1/4" Flr	N 66° W	329	217	Not Found

CS SURVEY RECORD

DATE:

PRESENT CONDITION:

18" Flr snag 35' high scribed 1/4 CSBT

26" Flr Scribed

CORNER SET: Found 2" rusted pipe and MAGNETIC DECLINATION: 20° W

1/4" square post scribed 1/4 S

BEARING AND DISTANCE TO ABOVE IDENTIFIED SURVEY ACCESSORIES:

BEARING-	FEET-	SURVEY-	
S 50° E	46.0	GLO	To root hole
N 71° E	35.0	CS	18" flr snag - 35' High Scribed 1/4 CSBT. Not known if recorded.
N 66° W	46.2	CS	26" Flr snagging visible not known if recorded.

CS 33/105-36

