


# PUBLIC LAND CORNERS

WEYERHAEUSER TIMBER COMPANY  
 SPRINGFIELD BRANCH

TOWNSHIP 22 S RANGE 1 W

SECTION 34 CORNER N 1

COUNTY DOUGLAS OREGON

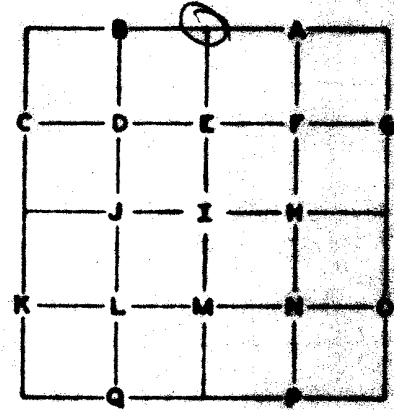

## GLO SURVEY RECORD

DATE: 1855

CORNER Post

PRESENT CONDITION - (DESCRIBE FULLY -  
 USE PAGE 2 IF NEEDED FOR EXPLANATION.)

No Trace

### ACCESSORIES:

	BEARING-	LINKS-	FEET-	
18" Flc	S 57° E	13	8.6	Not found
12" Flc	N 37° W	11	27	Back Scribed. Also Face Chopped Scribing Visible behind buel.

## SURVEY RECORD

DATE: \_\_\_\_\_

PRESENT CONDITION: \_\_\_\_\_

CORNER SET: "T" Bar 4lb W Haines

MAGNETIC DECLINATION: 20°

Cap. and 3"x6" Cedar Post

### BEARING AND DISTANCE TO ABOVE IDENTIFIED SURVEY ACCESSORIES:

BEARING-	FEET-	SURVEY-	
N 37° W	27.0	GLO	

CS 53/105-37

X

bv: 3  
bvd: 4

ACCESSORIES ADDED THIS DATE:

MAGNETIC DECLINATION

20'

	BEARING	FEET	ORIG. B.T.	"W" NAIL	PLATE	BRASS DISC
16" Fir	N 37° W	27.2	x	x	x	
52" Fir	N 66° E E	21.2		x	x	

IDENTIFIED ON PHOTO:

INFORMATION ON LOCATION OF CORNER AS NOW SET:

GROUND COVER: West edge creek flowing South

(USING FORM LINES SKETCH TOPOG AT CORNER ON PAGE 2 PLAT)

SLOPE FACES (GIVE BEARING IN DEGREES) South ON MINUS (-) 12 %

FROM CORNER ↓

NORTH: +12% up creek, Timbered to East & West

SOUTH: -12% along west side creek, Logged to East & West,

EAST: 5' to creek flows South, Level 10', then +40%. Logged to South,  
Timbered to North,

WEST: +10% 20', +40%. Logged to South, Timbered to North.

WORK DONE FOR W. T. CO.:

FIELD NOTES IN BOOK:

BY: Mc Chesney  
ENGINEER SURVEYOR

DATE: 1/29/58

UNDER THE SUPERVISION OF:

ASSISTED BY:

COPIES SENT TO:

SEAL