


PUBLIC LAND CORNERS

MEYERHAEUSER TIMBER COMPANY
 SPRINGFIELD BRANCH

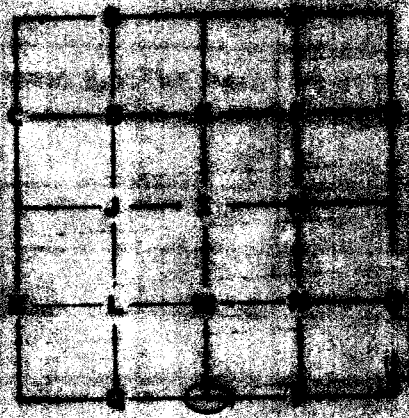

TOWNSHIP 22 S RANGE 10 W
 SECTION 33 CORNER SW
 COUNTY DOUGLAS STATE OK

GLO SURVEY RECORD

DATE: 1851
 CORNER Post

PRESENT CONDITION - (DESCRIBE FULLY -
 USE PAGE 2 IF NEEDED FOR EXPLANATION)

Trace

ACCESSORIES:

	BEARING-	LINKS-	FEET-	
12" Laurel	S 38 E	16	10.6	down, hollow, rotted, but scribing visible. 18" GLO
8" Elm	N 18 W	60	39.6	Green-face chopped. Scribing Visible. 20" GLO

SURVEY RECORD

DATE: _____

PRESENT CONDITION: _____

CORNER SET: Found 1" Iron Rod

MAGNETIC DECLINATION: 20°

1/4" Square Post

BEARING AND DISTANCE TO ABOVE IDENTIFIED SURVEY ACCESSORIES:

BEARING-	FEET-	
S 38° E	10	GLO
E 18° W	39.6	GLO

ACCESSORIES ADDED THIS DATE:

	BEARING-	FEET	ORIG. BT	W-NAIL	PLATE	BRASS DISC
258 Fir	N 17° W	30.5	x	x	x	
259 Fir	S 10° W	45.5		x	x	

IDENTIFIED ON PHOTO:

INFORMATION ON LOCATION OF CORNER AS NOW SET:

DESCRIPTION OF GROUND COVER AND GROUND SLOPE AT CORNER: Salal, Wild

Slope Faces NORTH on Minor Blackberry center

FROM CORNER NORTH: 25% 101' Old logging to West, Current Logging to East.

SOUTH: 29% 101' Logged to West, Timbered to East.

EAST: 25% 101' Timbered to South, current

WEST: 57' Logged to North & South

WORK DONE FOR W. T. CO.

BY: M Chesney
ENGINEER - SURVEYOR

DATE: _____

ASSISTED BY: _____

UNDER SUPERVISION OF:

COPIES SENT TO: _____

