


SECTION 21 TOWNSHIP 22 S RANGE 4 W

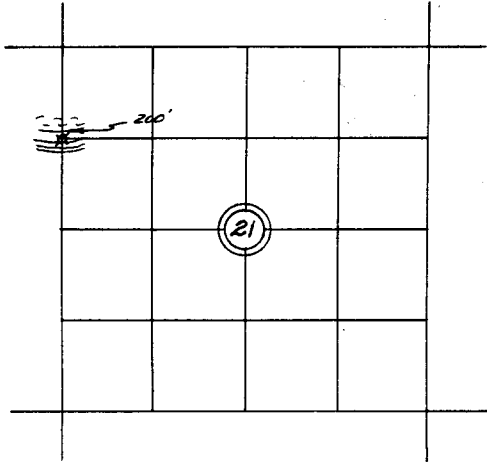

--- LINE MARKED BY NOTCH CUT IN BLAZE.

○...KNOWN CORNER.

⊗...REFERENCED CORNER
BY WEYERHAEUSER
METHOD.

This report is made for the purpose of correcting the referencing of N 1/16 Cor
between Sections 20 and 21. The corner established by Weyerhaeuser Company by
September 1962 survey was incorrectly placed and was rereferenced by this report
in same location as marked by a USGLO 1963 survey. The subdivision plat dated
September 25, 1962 filed with Douglas County Surveyor is correct.