


PUBLIC LAND CORNERS

SPRINGFIELD SURVEY FILE

WEYERHAEUSER TIMBER COMPANY
SPRINGFIELD BRANCH

TOWNSHIP 22 S RANGE 5 W
SECTION 3 CORNER NW
COUNTY Douglas OREGON

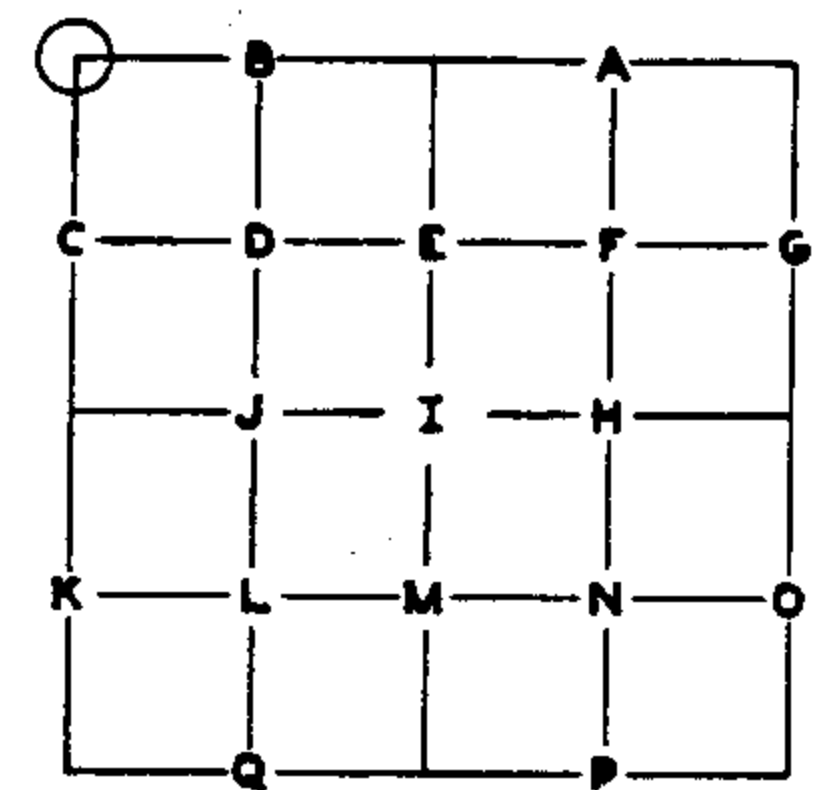

GLO SURVEY RECORD				PRESENT CONDITION - (DESCRIBE FULLY - USE PAGE 2 IF NEEDED FOR EXPLANATION.)
Gardener & Gordon 1855				
CORNER Post				Not found
ACCESSORIES:				
BEARING-	LINKS-	FEET-		
(1) Fir 30"	S 23° W	174	114.8	Not found
(2) Fir 36"	S 15° E	256	169.0	" "
(3) Fir 24"	N 3 1/2° E	211	139.3	" "
(4) Fir 20"	N 80° W	309	203.9	Stump - Cut in logging
County <u>Douglas</u> SURVEY RECORD DATE: <u>June 1938</u>				PRESENT CONDITION: <u>9/23/60</u>
Set 2" Iron Pipe				Not found
(5) 12" Chinquapin	N 10° E	271.5'		No trace
(6) 21" Fir	N 40° W	104.0'		24" Stump scribed "BT" good condition
(4) 44" Fir (Orig. BT)	N 80° W	205.0'		44" "School mom" Stump (not opened)
(7) 8" Alder	S 30° E	244.7'		10" Alder dead; Scribing legible

CORNER SET: 1" x 30" Alum Pipe MAG. DECL.: 20° E

BEARING AND DISTANCE TO ABOVE IDENTIFIED SURVEY ACCESSORIES:			
BEARING-	FEET-	SURVEY -	
(6) N 46° W	104.0	1938	24" Fir Stump; tree cut about 1950
(4) N 82° W	217.5	1855-1938	44" Stump; no scribing identified; if faced into wood originally (rather than bark scribe) The original face on stump has never been opened. Tree cut about 1950 probably destroyed scribing visible in 1938 survey.
(7) S 32° E	244.7	1938	10" Alder dead for several years; scribing not healed over and plainly visible.

ACCESSORIES ADDED THIS DATE:

MAGNETIC DECLINATION 20°

	BEARING	FEET	ORIG. B.T.	"W" NAIL	PLATE	BRASS DISC
(8) 6" Fir	S 70° E	82.2		X	X	
(9) 4" Incense Cedar	S 37° E	36.8		X	X	
(10) 4" Fir	S 78° W	44.2		X	X	
(6) 24" Fir Stump	N 46° W	104.0	(C.S.B.T.)	X	X	

IDENTIFIED ON PHOTO:

INFORMATION ON LOCATION OF CORNER AS NOW SET:

GROUND COVER: Open with grass and patches of Himalayan blackberry vines
(USING FORM LINES SKETCH TOPOG AT CORNER ON PAGE 2 PLAT)
SLOPE FACES (GIVE BEARING IN DEGREES) S 60° W ON MINUS (-) 8 %

NORTH: + 4% - Open - 150' to edge of logged area

SOUTH: - 5% - " 175' to spring branch, Course West

EAST: + 10% - " 600' to edge of logged area

WEST: - 6% - " 150' to edge of logged area

WORK DONE FOR W. T. CO.:

FIELD NOTES IN BOOK: _____

BY: [Signature] DATE: 9/23/60
~~ENGINEER - SURVEYOR~~
Land Agent

ASSISTED BY: Glen McChesney

UNDER THE SUPERVISION OF: _____

COPIES SENT TO: _____

CS 53/105 - A8