


# PUBLIC LAND CORNERS

**WEYERHAEUSER TIMBER COMPANY  
SPRINGFIELD BRANCH**

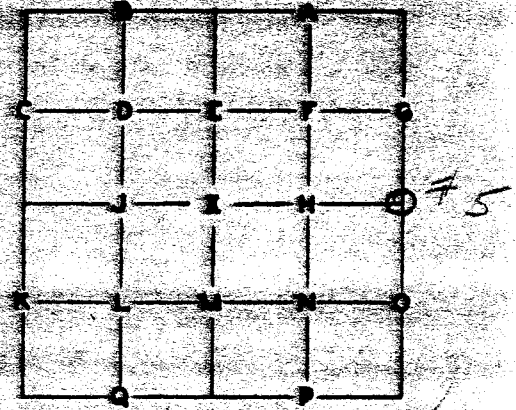

TOWNSHIP 23 S RANGE 2 W  
SECTION 31 CORNER E 1/4  
COUNTY DOUGLAS OREGON

**GLO SURVEY RECORD**

DATE: 1896  
CORNER N 1/4

**PRESENT CONDITION - (DESCRIBE FULLY)**

ROAD 1/4  
THIS CORNER WAS SET BY THE  
DOUGLAS COUNTY PLAT 100 1885  
THIS CORNER WAS SET BY THE  
SHELDON PLAT 100 1885

**ACCESSORIES:**

	BEARING-	LINKS-	FEET-
30" PFB	N 81° W	1.2	11
30" PFB	N 2° E	1.2	11

**SURVEY RECORD**

DATE: \_\_\_\_\_

**PRESENT CONDITION:**

\_\_\_\_\_

CORNER SET: VINE MAPLE STAKE MAGNETIC DECLINATION: 20° E  
SEPTEMBER 18 1895

**BEARING AND DISTANCE TO ABOVE IDENTIFIED SURVEY ACCESSORIES:**

BEARING-	FEET-	
N 81° W	1.2	30" PFB
N 2° E	1.2	30" PFB

CS 53/106-6

53/106

**ACCESSORIES ADDED THIS DATE:**

	BEARING -	FEET -	"W" NAIL -	PLATE -	BRASS DESC -
54" FIR (ORIG. II)	S 81° W	20.4	X	X	
46" FIR	S 25° E	11.4	X	X	

**IDENTIFIED ON PHOTO:**

**INFORMATION ON LOCATION OF CORNER AS NOW SET:**

**DESCRIPTION OF GROUND COVER AND GROUND SLOPE AT CORNER:** OLD GROWTH FIR W.

HEAVY GROUND COVER OF LIVE MAPLE & BALSAM. SLOPE S 25° W.

**FROM CORNER NORTH:** 60% SLOPE

**SOUTH:** 40% SLOPE - 100' PINE - 100' PINE

**EAST:** 40% SLOPE

**WEST:** 40% SLOPE

**WORK DONE FOR W. T. CO.**

*W. T. CO.*

**BY:** \_\_\_\_\_  
ENGINEER - SURVEYOR

**DATE:** SEPTEMBER 18 1914

**ASSISTED BY:** \_\_\_\_\_

DEAN E. WILSON

HARVEY E. CASE

**UNDER SUPERVISION OF:**

WILSON D. HALE  
REG. PROF. SURVEYOR  
STATE NO. 1243

**COPIES SENT TO:** \_\_\_\_\_

SEAL

53/106