


PUBLIC LAND CORNERS

**WEYERHAEUSER TIMBER COMPANY
SPRINGFIELD BRANCH**

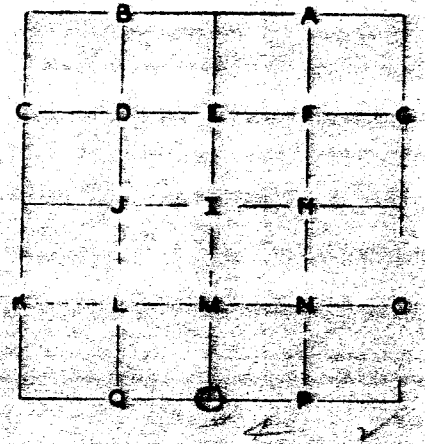

TOWNSHIP 22 S RANGE 14 W

SECTION 11 CORNER SO. E.

COUNTY DELAWARE OREGON

GLO SURVEY RECORD

DATE: APR 21 1894

CORNER POST

**PRESENT CONDITION - (DESCRIBE FULLY
USE PAGE 2 IF NEEDED FOR EXPLANATION)**

ONE

ACCESSORIES:

	BEARING-	LINKS-	FEET-	
5" YOUNG MAPLE	N 47° E	15	11.36	<u>ONE</u>
30" FIR	S 60° E	27	17.8	<u>ONE FIR STUMP, CHECKED BY GLO</u>

SURVEY RECORD

DATE: _____

PRESENT CONDITION: _____

CORNER SET: 5/8" x 30" MONEL PIPE

MAGNETIC DECLINATION: 20° E

NEAR A 2" x 3.6" BLACK IRON PIPE SET 1 1/2 FEET NE. 1 FT. IN THE GROUND

BEARING AND DISTANCE TO ABOVE IDENTIFIED SURVEY ACCESSORIES:

BEARING-	FEET-		
S 60° E	17.8	30" FIR STUMP	<u>ORIGINAL BY</u>

CS 53/106-B

[Signature]

ACCESSORIES ADDED THIS DATE:

	BEARING-	FEET	ORIG. BT	W ² -NAIL	PLATE	BRASS DISC
42" FILE STRIP	N 24° E	28.8		X	X	
33" FILE STRIP (ORIG. 42")	S 60° E	17.9	X	X	X	

IDENTIFIED ON PHOTO:

INFORMATION ON LOCATION OF CORNER AS NOW SET:

DESCRIPTION OF GROUND COVER AND GROUND SLOPE AT CORNER: WOODS

200 SW 1/4 SEC 36, CORNER IN SMALL PENCIL AND

FROM CORNER NORTH: + 100' FOR 100', LEVEL ABOUT 100' TO THE

SOUTH: LEVEL FOR 50', THENCE 100' FOR 100'

EAST: 400' FOR 100', THENCE 100' FOR 100', AT A POINT 100' TO THE
TEMPER.

WEST: + 100' FOR 100'

WORK DONE FOR W. T. CO.

Marion D. Hale

BY: _____ DATE: JANUARY 15 1948
ENGINEER - SURVEYOR

ASSISTED BY: BARLET E. CASE
UNDER SUPERVISION OF:

COPIES SENT TO: _____

