


# PUBLIC LAND CORNERS

WEYERHAEUSER TIMBER COMPANY  
 SPRINGFIELD BRANCH

TOWNSHIP 23 S RANGE 3 W

SECTION 34 CORNER SE

COUNTY Douglas OREGON

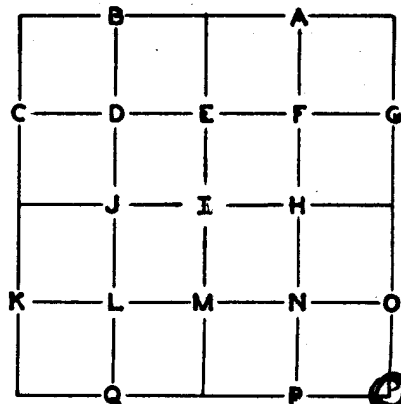

## GLO SURVEY RECORD

DATE: Aug. 1882  
 CORNER Post

PRESENT CONDITION - (DESCRIBE FULLY -  
 USE PAGE 2 IF NEEDED FOR EXPLANATION.)

Post gone

### ACCESSORIES:

	BEARING-	LINKS-	FEET-	
6" maple	S 40° W	49	32.34	Now 8" - axe notch - No scribing visible
20" Fir	N 30° W	44	29.04	Now snag bucket tape N 19° W, some scribing on bank visible.
36" Fir	N 15° E	45	29.70	N 46° E - Most scribing visible on bank
36" Fir	S 1° E	19	12.54	S 5° E - scribe on bank, visible.

W.T.C.O. SURVEY RECORD  
 DATE: 1954

PRESENT CONDITION:

28" Fir snag N 24° W 29.7' - w. nail-plate & B.T. Destroyed WTC's reference  
 60" Fir N 44° E 30.0' " " " " " Void - See new reference  
scribe on bank

CORNER SET: 3/4 x 35' Iron rod MAGNETIC DECLINATION: 20° E


### BEARING AND DISTANCE TO ABOVE IDENTIFIED SURVEY ACCESSORIES:

BEARING-	FEET-	SURVEY -	
S 46° W	32.3	GLO	8" VM - 1's Orig
N 19° W	29.0	"	Broken top snag Orig
N 46° E	29.7	"	Orig BT
S 5° E	12.5	"	Orig BT

CS 53/107-14

6

SECTION \_\_\_\_\_ TOWNSHIP \_\_\_\_\_ RANGE \_\_\_\_\_

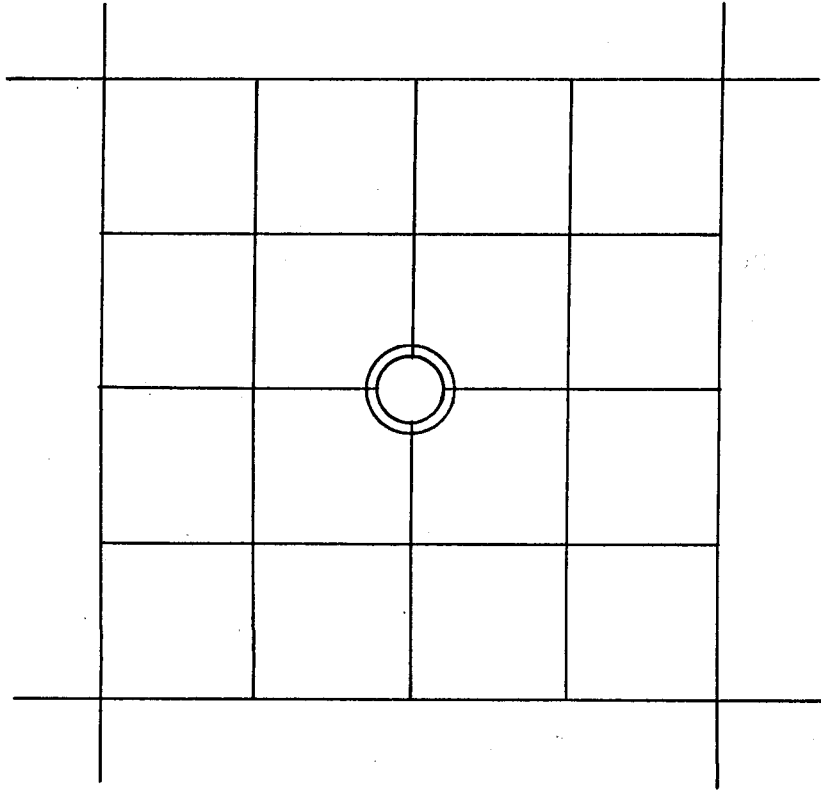

—//—//—//— LINE MARKED BY NOTCH CUT IN BLAZE.

○—KNOWN CORNER.

⊗—REFERENCED CORNER BY WEYERHAEUSER METHOD.

ACCESSORIES ADDED THIS DATE:

MAGNETIC DECLINATION V20°E

	BEARING	FEET	ORIG. B. T.	"W" NAIL	PLATE	BRASS DISC
42" Fir	S 45° W	36.6		✓	✓	
50" Fir	N 59° W	51.0		✓	✓	
42" Fir	N 46° E	31.0	✓	✓	✓	
52" Fir	S 5° E	10.3	✓	✓	✓	

IDENTIFIED ON PHOTO:

INFORMATION ON LOCATION OF CORNER AS NOW SET: about 6' south of Swale

GROUND COVER: O.G.F. Salal, some misc. shrub, young Hemlock, & live maple

(USING FORM LINES SKETCH TOPOG AT CORNER ON PAGE 2 PLAT)

SLOPE FACES (GIVE BEARING IN DEGREES) N 42° W ON MINUS (-) -35 %

FROM CORNER -

NORTH: -11% about 180°

SOUTH: +24%

EAST: +40% about 10°

WEST: -20% about 80°

WORK DONE FOR W. T. CO.:

FIELD NOTES IN BOOK: \_\_\_\_\_

BY: M. D. Hale  
ENGINEER - SURVEYOR

DATE: 6-12-58

UNDER THE SUPERVISION OF:

ASSISTED BY: Harley Eldon Case

COPIES SENT TO: \_\_\_\_\_

SEAL