


PUBLIC LAND CORNERS

b7c

WEYERHAEUSER TIMBER COMPANY
 SPRINGFIELD BRANCH

TOWNSHIP 23 S RANGE 3 W
 SECTION 36 CORNER N 1/4
 COUNTY DOUGLAS OREGON

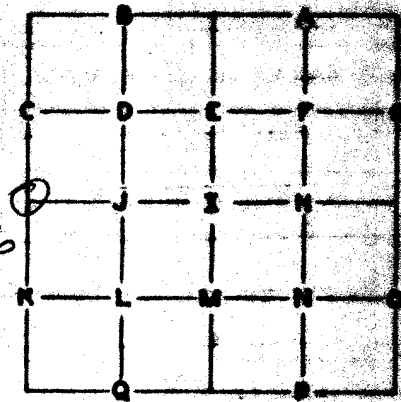

GLO SURVEY RECORD

DATE: 1882
 CORNER POST

PRESENT CONDITION - (DESCRIBE FULLY -
 USE PAGE 2 IF NEEDED FOR EXPLANATION.)
 OCTOBER 15 1927

CONE
 CRUISE MARKS

ACCESSORIES:

	BEARING-	LINKS-	FEET-	
30" FIR	S 40° E	25		SCRIBED ON MARK, MOSTLY LEGIBLE, FACE BEARS N 70° W
24" FIR	WEST	30		26" FIR, NO SCRIBES, FAYND

SURVEY RECORD

DATE:

PRESENT CONDITION:

CORNER SET: 1/4" x 10" MONEL PIPE MAGNETIC DECLINATION: 20°

BEARING AND DISTANCE TO ABOVE IDENTIFIED SURVEY ACCESSORIES:

BEARING-	FEET-	
S 70° E	16.3	ORIGINAL BY 1/4" FIR
N 70° W	23.7	POSSIBLE ORIGINAL BY NO MARKS

CS 53/107-15

46

PAGE 1

ACCESSORIES ADDED THIS DATE:

	BEARING-	FEET	ORIG. BT	W ² -NAIL	PLATE	BRASS DISC
58" FIR ORIGINAL PT	S 70° E	16.3	X	X		
54" FIR	N 88° W	40.7	X	X		

IDENTIFIED ON PHOTO:

INFORMATION ON LOCATION OF CORNER AS NOW SET:

DESCRIPTION OF GROUND COVER AND GROUND SLOPE AT CORNER: 8" G. FIR, SAKAI,
AND SEA FOAM, SOUTH & SOUTHWEST, GENTLE SLOPE

FROM CORNER NORTH: + 15% NORTH

SOUTH: - 12% FOR 20' THENCE BECOMES STEPPER

EAST: + 8% FOR 20' TO SMALL WEDGE THERE BECOMES GENTLE SLOPE

WEST: - 5% FOR 20'

WORK DONE FOR W. T. CO.

BY: M. D. Hale
 ENGINEER - SURVEYOR

DATE: OCTOBER 16, 1957

ASSISTED BY: WARREN OLSON

UNDER SUPERVISION OF:

COPIES SENT TO: KIMMELIN

SEAL