


PUBLIC LAND CORNERS

WEYERHAEUSER TIMBER COMPANY
 SPRINGFIELD BRANCH

TOWNSHIP 23 S RANGE 3 W
 SECTION 36 CORNER E 1/4
 COUNTY DOUGLAS OREGON

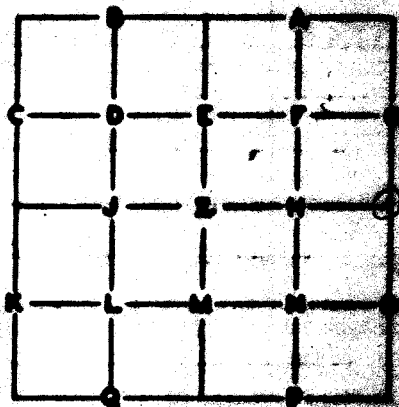

GLO SURVEY RECORD

PRESENT CONDITION - (DESCRIBE FULLY)

DATE: 1882
 CORNER POST

POST GONE

ACCESSORIES:

	BEARING-	LINKS-	FEET-
DOUBLE FIR	NORTH	8	
5" FIR	S 10° E	80	

SCRIBING "BT" BARELY VISIBLE ON BARK. 'X' ON EAST & WEST SIDE. NO WEYER MARK, ONE NAME.

AXE MARKS EVIDENT. NO SCRIBING FOUND

SURVEY RECORD
 DATE: _____

PRESENT CONDITION: _____

CORNER SET: CEDAR STAKE 1/2"x2"x3'
SEPTEMBER 18, 1957

MAGNETIC DECLINATION: 20° E

BEARING AND DISTANCE TO ABOVE IDENTIFIED SURVEY ACCESSORIES:

BEARING-	FEET-	
NORTH	5.1	DOUBLE FIR, ORIG. BT
S 4° W	41.4	46" FIR ORIG. BT

CS 53/107-16

ACCESSORIES ADDED THIS DATE:

	BEARING -	FEET -	"W" NAIL -	PLATE -	BRASS DISC -
70" DOUBLE FIR. E SECTION - SNAG (ORIG. E.)	NORTH	4.4	X	X	
3.5" INCENSE CEDAR	S 75° E	39.7	X	X	

IDENTIFIED ON PHOTO:

INFORMATION ON LOCATION OF CORNER AS NOW SET:

DESCRIPTION OF GROUND COVER AND GROUND SLOPE AT CORNER: RHODODENDRON, OLD SNAG
FIR ON CROWN OF SMALL SNAG SLOPING SW.

FROM CORNER NORTH: + 14% SLOPE UP INCH

SOUTH: + 17% SLOPE

EAST: + 12% SLOPE

WEST: + 35% SLOPE CREEK BOTTOM 150' WEST

WORK DONE FOR W. T. CO.

BY: Hale DATE: SEPTEMBER, 1957
 ENGINEER - SURVEYOR

ASSISTED BY: _____

DEAN E. ANLRIK

HARL. F. CASE

UNDER SUPERVISION OF:

MARION D. HALE
 REG. PROF. SURVEYOR
 SURVEY NO. 243

COPIES SENT TO: _____