


PUBLIC LAND CORNERS

WEVERHAEUSER TIMBER COMPANY
 SPRINGFIELD BRANCH

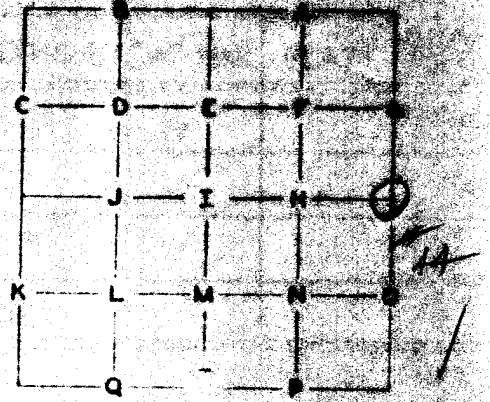

TOWNSHIP _____ RANGE _____ W

SECTION _____ CORNER _____

COUNTY _____ OREGON

GLO SURVEY RECORD

DATE: _____

CORNER _____

PRESENT CONDITION - (DESCRIBE FULLY -
 USE PAGE 2 IF NEEDED FOR EXPLANATION)

ACCESSORIES:

	BEARING-	LINKS-	FEET-

WEX WTC. SURVEY RECORD

DATE: _____

PRESENT CONDITION: _____

L. C. Fisher

Brass plate

CORNER SET: _____

MAGNETIC DECLINATION: _____

BEARING AND DISTANCE TO ABOVE IDENTIFIED SURVEY ACCESSORIES:

BEARING-	FEET-	SURVEY-

CS 03 07 - 17

ACCESSORIES ADDED THIS DATE

MAGNETIC DECLINATION 20° E

	BEARING	FEET	ORIG. B.T.	"W" NAIL	PLATE	BRASS DISC
60" Fir	N 51° E	52.4		x	x	
60" Fir	S 86° W	42.9		x	x	

IDENTIFIED ON PHOTO:

INFORMATION ON LOCATION OF CORNER AS NOW SET:

GROUND COVER: O.G. Fir, Hemlock; 2nd Growth Fir, Sapling Hem., Yew, Maple, ~~Sitka~~

(USING FORM LINES SKETCH TOPOG AT CORNER ON PAGE 2 PLAT)

SLOPE FACES (GIVE BEARING IN DEGREES) N 23° E ON MINUS (-) 76%

FROM CORNER ↓

NORTH: - 72% for 180'

SOUTH: + 60% for 100'

EAST: - 25% for 200'

WEST: + 12% for 50' ridge, then descend

WORK DONE FOR W. T. CO.:

FIELD NOTES IN BOOK:

BY: Hale
ENGINEER - SURVEYOR

DATE: 2/58

ASSISTED BY: Harley E. Case

Gordon Waller

COPIES SENT TO:

UNDER THE SUPERVISION OF

SEAL