


PUBLIC LAND CORNERS

Douglas

**WEYERHAEUSER TIMBER COMPANY
SPRINGFIELD BRANCH**

TOWNSHIP 23 S RANGE 3 W
SECTION 27 CORNER Et
COUNTY LANE & DOUGLAS LINE OREGON

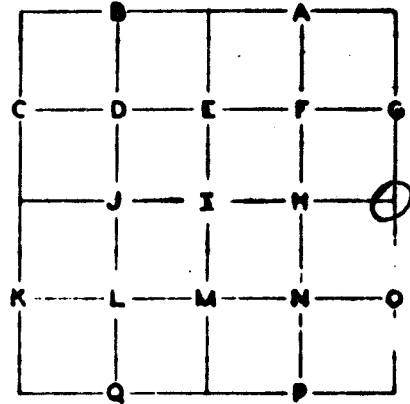

Sutterlin book #72

GLO SURVEY RECORD

DATE: 1882
CORNER 6" Hemlock

PRESENT CONDITION - (DESCRIBE FULLY - USE PAGE 2 IF NEEDED FOR EXPLANATION.)

Hemlock is a 15" diameter broken off near ground level by logging; burnt and no scribing visible, but I saw hole corner in April, 1956 when the area was felled and bucked timber, at that time scribing was visible.

ACCESSORIES:

	BEARING-	LINKS-	FEET-
50" Fir	South	12	
60" Fir	N 20° E	25	

60" burned out fir snag stump
Tree gone, hole in ground at the approximate location.

SURVEY RECORD

Found:
U.S. B.L.M. plate, marked 235, W, Sec. 27

PRESENT CONDITION:

O.K.

CORNER SET: 1"x2" Cedar Stake

MAGNETIC DECLINATION: 20° E

Set in broken off Hemlock for corner.

BEARING AND DISTANCE TO ABOVE IDENTIFIED SURVEY ACCESSORIES:

BEARING-	FEET-	
S 31° W	8.0	60" burned out fir snag stump, possible Orig. BT, no scribing visible or evident.
N 20° E	25.0	Tree gone, hole in ground.

CS 53 / 107-20

ACCESSORIES ADDED THIS DATE:

	BEARING-	FEET	ORIG. BT	W ^o -NAIL	PLATE	BRASS DISC
28" Cedar Stump	N 73 1/2° E	10.8	x	X	x	
48" Fir Stump	N 37° W	16.0		x	x	

IDENTIFIED ON PHOTO:

INFORMATION ON LOCATION OF CORNER AS NOW SET:

DESCRIPTION OF GROUND COVER AND GROUND SLOPE AT CORNER: SE quadrant, 00 timber, NE, NW & SW quadrants. logged ground slope from NW

FROM CORNER NORTH: _____

SOUTH: 100 ft for 100 ft slope distance.

EAST: _____

WEST: _____

WORK DONE FOR W. T. CO.

BY: Hale ENGINEER - SURVEYOR DATE: January, 1958

ASSISTED BY: Douglas Warner
Ronald J. [unclear]
Ronald J. [unclear]

UNDER SUPERVISION OF:

COPIES SENT TO: _____

