


PUBLIC LAND CORNERS

WEYERHAEUSER TIMBER COMPANY
 SPRINGFIELD BRANCH

TOWNSHIP 23 S RANGE 3 W
 SECTION 27 CORNER SE
 COUNTY DEWEE OREGON

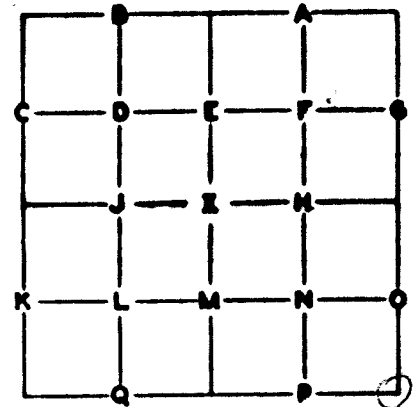

CESTARE DRIVE FIELD No. C.G.6

GLO SURVEY RECORD

DATE: _____

CORNER _____

ACCESSORIES:

	BEARING-	LINKS-	FEET-
8" CEDAR	S 70° W	1	1.5
33" CEDAR	S 70° W	1	1.5
30" CEDAR	N 70° W	1	1.5
5" MAPLE	N 70° E	1	1.5

PRESENT CONDITION - (DESCRIBE FULLY)

POST: _____

SURVEY RECORD

DATE: _____

PRESENT CONDITION:

CORNER SET: _____

MAGNETIC DECLINATION: _____

BEARING AND DISTANCE TO ABOVE IDENTIFIED SURVEY ACCESSORIES:

BEARING-	FEET	
N 50° W	1.5	8" CEDAR ORIGINAL
S 63° W	1.5	33" CEDAR ORIGINAL

CS 53/10/22

ACCESSORIES ADDED THIS DATE:

	BEARING -	FEET -	"W" NAIL -	PLATE -	BRASS DISC -
24" CEDAR	S 5° W	15.0	X	X	
48" CEDAR (ORIGINAL PT)	N 50° W	2.9	X	X	
46" CEDAR (ORIGINAL PT)	S 63° W	3.1	X	X	
26" CEDAR	N 12° W	28.1	X	X	

IDENTIFIED ON PHOTO:

INFORMATION ON LOCATION OF CORNER AS NOW SET:

DESCRIPTION OF GROUND COVER AND GROUND SLOPE AT CORNER: FLAT SWAMPY GROUND.

N REFERENCES SET ON EAST SIDE D.F. TO FUTURE ROAD CONSTRUCTION.

FROM CORNER NORTH: _____

SOUTH: _____

EAST: _____

WEST: _____

WORK DONE FOR W. T. CO.

BY: Hale DATE: MARCH 6, 1957
 ENGINEER - SURVEYOR

ASSISTED BY: DOUGLAS WARNER
RONALD YOUNG
GORDON WALLER

UNDER SUPERVISION OF:

COPIES SENT TO: _____

