


# PUBLIC LAND CORNERS

WEYERHAEUSER COMPANY  
 SPRINGFIELD BRANCH

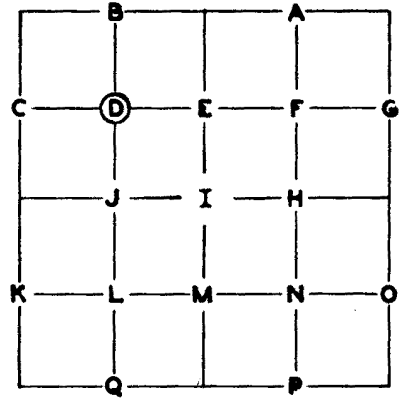


TOWNSHIP 23S RANGE 4W  
 SECTION 12 CORNER NE 1/16 "D"  
 COUNTY Douglas OREGON

<p><b>GLO SURVEY RECORD</b></p> <p>CORNER <u>Not set by GLO</u> DATE: <u>Nov. 1963</u></p> <p><b>ACCESSORIES:</b></p> <table border="1" style="width:100%; border-collapse: collapse;"> <thead> <tr> <th style="width:15%;">BEARING-</th> <th style="width:15%;">LINKS-</th> <th style="width:15%;">FEET-</th> </tr> </thead> <tbody> <tr><td> </td><td> </td><td> </td></tr> <tr><td> </td><td> </td><td> </td></tr> <tr><td> </td><td> </td><td> </td></tr> <tr><td> </td><td> </td><td> </td></tr> <tr><td> </td><td> </td><td> </td></tr> <tr><td> </td><td> </td><td> </td></tr> <tr><td> </td><td> </td><td> </td></tr> <tr><td> </td><td> </td><td> </td></tr> <tr><td> </td><td> </td><td> </td></tr> <tr><td> </td><td> </td><td> </td></tr> </tbody> </table>	BEARING-	LINKS-	FEET-																															<p><b>PRESENT CONDITION - (DESCRIBE FULLY - USE PAGE 2 IF NEEDED FOR EXPLANATION.)</b></p>
BEARING-	LINKS-	FEET-																																
<p><b>W. N. Haines SURVEY RECORD</b>                  DATE: <u>Nov. 1963</u>                  Transit survey                  Set 1"x36" "T" Iron and scribed:</p> <p>30" Incease Cedar N59°E 24.2°                  (N80°E true)</p> <p>12" Douglas-fir S10°E 33.8°                  (S11°W true)</p>	<p><b>PRESENT CONDITION:</b></p> <p>32" Incease Cedar - scribing visible</p> <p>12" Douglas-fir - face partly healed over</p>																																	

CORNER SET: "T" iron as set by Haines Survey MAG. DECL.: 20°

**BEARING AND DISTANCE TO ABOVE IDENTIFIED SURVEY ACCESSORIES:**

BEARING-	FEET-	SURVEY -	
N59°E	22.7	Haines '63	to scribed face
S11°E	33.8	Haines '63	to scribed face

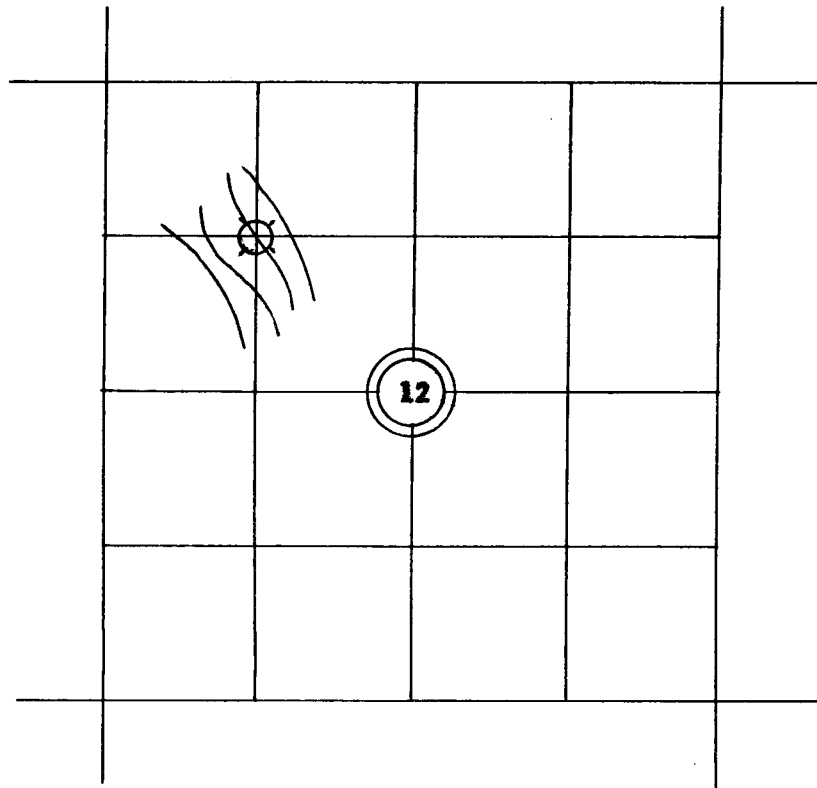

— // — // — // — LINE MARKED BY NOTCH CUT IN BLAZE.

○...KNOWN CORNER.

⊗...REFERENCED CORNER BY WEYERHAEUSER METHOD.

**Note: 21° local magnetic attraction at vicinity of this corner.**

ACCESSORIES ADDED THIS DATE:

MAGNETIC DECLINATION 20°

	BEARING	FEET	ORIG. B.T.	"W" NAIL	PLATE	BRASS DISC
12" Douglas-fir	S11°E	22.6	Haines 1963	X	X	
32" Incense Cedar	N59°E	33.3	Haines 1963	X	X	

IDENTIFIED ON PHOTO:

INFORMATION ON LOCATION OF CORNER AS NOW SET:

GROUND COVER: fern, brush

(USING FORM LINES SKETCH TOPOG AT CORNER ON PAGE 2 PLAT)

SLOPE FACES (GIVE BEARING IN DEGREES) S55°W ON MINUS (-) 12 %

NORTH: + 5

FROM CORNER | SOUTH: + 6

EAST: + 25

WEST: - 12

WORK DONE FOR W. CO. \_\_\_\_\_

FIELD NOTES IN BOOK: \_\_\_\_\_

BY: Glen McChesney DATE: 8/9/66  
~~ENGINEER~~

UNDER THE SUPERVISION OF:

ASSISTED BY: \_\_\_\_\_

COPIES SENT TO: \_\_\_\_\_

SEAL

PAGE 3

C. S. File No. 53/108