


PUBLIC LAND CORNERS

**WEYERHAEUSER TIMBER COMPANY
SPRINGFIELD BRANCH**

TOWNSHIP 23 S RANGE 5 E

SECTION 36 CORNER E 1/4

COUNTY DOUGLAS OREGON

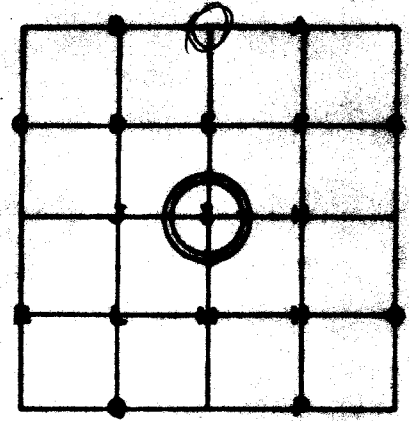

GLO SURVEY RECORD

CORNER _____ DATE: _____

PRESENT CONDITION - (DESCRIBE FULLY)

ACCESSORIES:

BEARING-	CHAINS-	FEET-

SURVEY RECORD _____ DATE: _____

PRESENT CONDITION: _____

CORNER SET: BRASS CAP MAGNETIC DECLINATION: 20°

BEARING AND DISTANCE TO ABOVE IDENTIFIED SURVEY ACCESSORIES:

BEARING-	FEET-	
S 82° E	76.9	Original BT-Chopped out - Scribing barely visible due to stump rot in tree - a 24" Black Oak.
N 47° W	17.4	A 30" Laurel-Original BT-Chopped out, scribing plainly visible.
N 15° W	32.0	A 7" Chinquapin - newly scribed Gov't. BT.
S 80° W	11.7	A 9" Fir - newly scribed Gov't. BT.

CS 53/109

PAGE 1

ACCESSORIES ADDED THIS DATE:

	BEARING -	FEET -	"W" NAIL -	PLATE -	BRASS DISC -
7" Chinquapin	N 15° W	32.0	X	X	New Gov't. 87
9" Fir	S 20½° W	11.7	X	X	New Gov't. 87

IDENTIFIED ON PHOTO:

INFORMATION ON LOCATION OF CORNER AS NOW SET:

DESCRIPTION OF GROUND COVER AT CORNER: U.S. 00 to the North, logged to
the South. Slightly SE slope.

FROM CORNER NORTH: Slight Ascend - U.S. 00 Timber

SOUTH: Descend to creek approx. 300' - logged.

EAST: Slight Descend - U.S. 00 to North, clear cut to
South.

WEST: Slight Ascend - U.S. 00 to North, clear cut to
South.

WORK DONE FOR W. T. CO.

BY: Lovstead
 ENGINEER - SURVEYOR

DATE: May 8, 1957

ASSISTED BY: Robert Barta

UNDER SUPERVISION OF:

COPIES SENT TO: