

SPRINGFIELD
SURVEY FILE


PUBLIC LAND CORNERS

WEYERHAEUSER COMPANY
 SPRINGFIELD BRANCH

TOWNSHIP 24 S RANGE 2 W # 19

SECTION 7 CORNER W 1/4

COUNTY Douglas OREGON

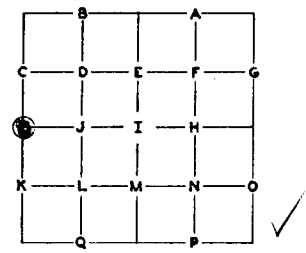

GLO SURVEY RECORD

DATE: 1883

CORNER Post

PRESENT CONDITION - (DESCRIBE FULLY -
 USE PAGE 2 IF NEEDED FOR EXPLANATION.)

Gone

ACCESSORIES:

	BEARING-	LINKS-	FEET-
24" Hemlock	N 40° E	30	19.8
5" Vine Maple	S 45° W	29	19.1

Windfall - 24" Hemlock

Gone

SURVEY RECORD

DATE:

PRESENT CONDITION:

CORNER SET: Log at place for corner MAG. DECL.: 20° E

No corner set

BEARING AND DISTANCE TO ABOVE IDENTIFIED SURVEY ACCESSORIES:

BEARING-	FEET-	SURVEY -
N 40° E	19.8	1883

Estimated original position of Hemlock windfall and set
 a point on a log for corner from original notes.

ACCESSORIES ADDED THIS DATE:

MAGNETIC DECLINATION 20° E

	BEARING	FEET	ORIG. B.T.	"W" NAIL	PLATE	BRASS DISC
14" Hemlock	S 61° E	60.2	--	X	X	--
62" Fir	N 57 W	102.9	--	X	X	--

IDENTIFIED ON PHOTO:

INFORMATION ON LOCATION OF CORNER AS NOW SET:

GROUND COVER: O.G. Fir & Wind Falls, V. Maple, Small Hem., & Fern

(USING FORM LINES SKETCH TOPOG AT CORNER ON PAGE 2 PLAT)

SLOPE FACES (GIVE BEARING IN DEGREES) North ON MINUS (-) ²⁰ 9/10

NORTH: - 20% for 200'

SOUTH: + 33% for 100' - Ridge

EAST: + 14% for 200' - Ridge

WEST: + 14% for 150'

WORK DONE FOR W. CO.

FIELD NOTES IN BOOK:

By: M.D. Hale R.B. DATE: July 6, 1961

ENGINEER SURVEYOR

UNDER THE SUPERVISION OF:

ASSISTED BY: Bruce Malcom

COPIES SENT TO:

CS 53/110-3