


PUBLIC LAND CORNERS

WEYERHAEUSER COMPANY
 SPRINGFIELD BRANCH

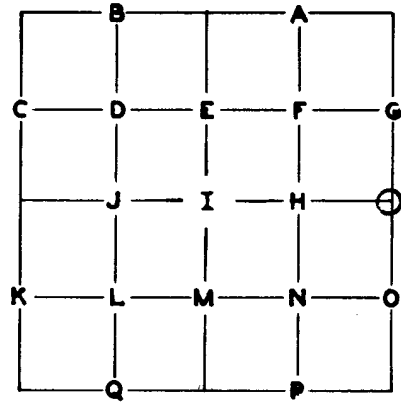

TOWNSHIP 24S RANGE 2W
 SECTION 4 CORNER E $\frac{1}{2}$
 COUNTY Douglas OREGON

GLO SURVEY RECORD				PRESENT CONDITION - (DESCRIBE FULLY - USE PAGE 2 IF NEEDED FOR EXPLANATION.)
DATE: <u>9/19/1894</u>				No trace of original
CORNER <u>Post</u>				
ACCESSORIES:				
BEARING-	LINKS-	FEET-		
18" Hemlock	S39°W	45	29.7	No trace
7" Hemlock	S50°E	8	5.3	Down 10" Hemlock - scribbling visible
Weyerhaeuser Co. SURVEY RECORD				PRESENT CONDITION:
DATE: <u>7/19/54</u>				
Found 2 BTs Set pipe & 2 Tags:				No pipe. Found post not in correct corner location.
24" Cedar	N50°E	27.9'		24" Cedar with tags & "W" nails
36" Fir	S78°W	17.0'		36" Fir " " "
(See Page 2 for Douglas County Survey Record)				I removed these 1954 plates. My referenced this date (10/25/68) supersede any previous references.


CORNER SET: Brass cap set by Douglas County Survey crew MAG. DECL.: 20°

from root hole of down SE BT. Drove post beside BC

BEARING AND DISTANCE TO ABOVE IDENTIFIED SURVEY ACCESSORIES:

BEARING-	FEET-	SURVEY -	
S50°E	5.3	GLO-1894	Distance & bearing to center of root hole
N52°E	28.6	W.CO.	Distance & bearing to "W" nail.
S77°W	15.7	"	" " "

SECTION 4 TOWNSHIP 24S RANGE 2W

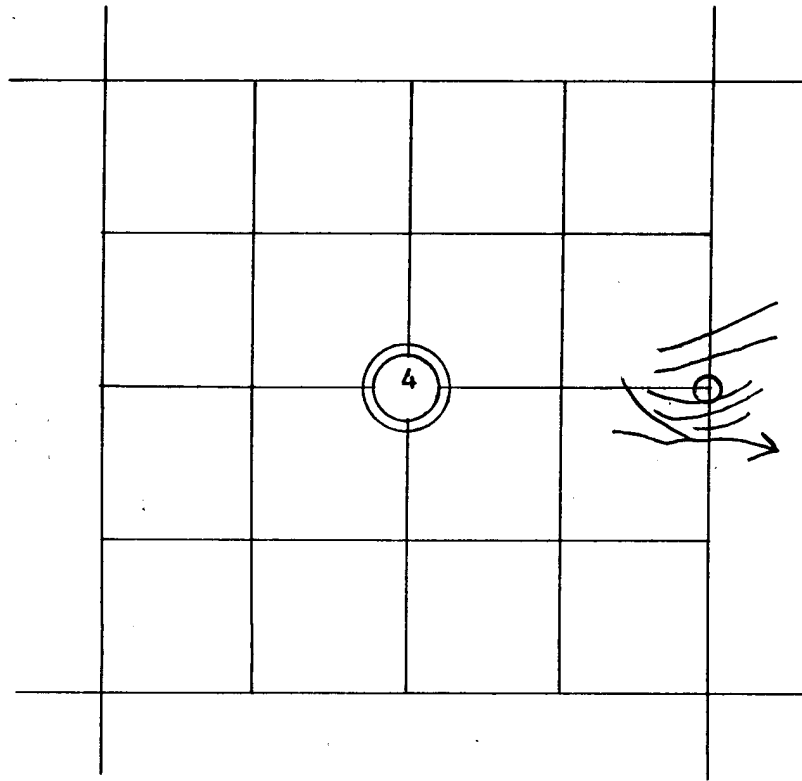

—//—//—//— LINE MARKED BY NOTCH CUT IN BLAZE.

○—KNOWN CORNER.

⊗—REFERENCED CORNER
BY WEYERHAEUSER
METHOD.

Douglas County Survey Record 10/25/68

Set brass cap according to GLO call from center of root hole of down

original SE BT and scribed 2 new BTs:

8" Hemlock N69°W 12.4'

9" Hemlock N20°E 14.5'

ACCESSORIES ADDED THIS DATE:

MAGNETIC DECLINATION

20°

	BEARING	FEET	ORIG. B.T.	"W" NAIL	PLATE	BRASS DISC
24" Cedar	N52°E	28.6	W.Co.	X	X	-
36" Fir stump	S77°W	15.7	W.Co.	X	X	-

IDENTIFIED ON PHOTO:

INFORMATION ON LOCATION OF CORNER AS NOW SET:

GROUND COVER: Rhododendron, logging slash

(USING FORM LINES SKETCH TOPOG AT CORNER ON PAGE 2 PLAT)

SLOPE FACES (GIVE BEARING IN DEGREES) S30°E ON MINUS (-) 45 %

NORTH: + 40% logged to west; virgin old growth to east

SOUTH: - 45% logged for 600' to west; virgin old growth to east

EAST: - 25% virgin old growth to north and south

WEST: + 20% logged to north and south

WORK DONE FOR W. CO.

FIELD NOTES IN BOOK:

BY: Glen McChasney DATE: 10/25/68

~~ENGINEER~~
Project Engineer

ASSISTED BY: Douglas County Survey crew present

COPIES SENT TO:

UNDER THE SUPERVISION OF:

SEAL

PAGE 3

C. S. File No. 53/110