


PUBLIC LAND CORNERS

**WEYERHAEUSER TIMBER COMPANY
SPRINGFIELD BRANCH**

TOWNSHIP 24 S RANGE 2 W
SECTION 28 CORNER NE 1/4
COUNTY DOUGLAS OREGON

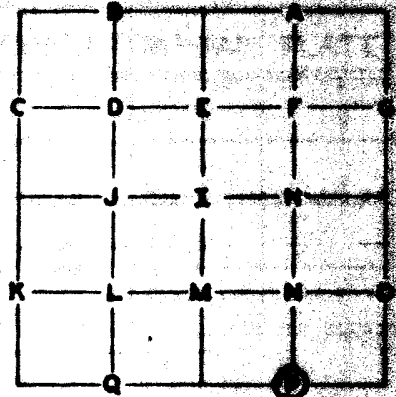

GLO SURVEY RECORD

**PRESENT CONDITION - (DESCRIBE FULLY -
USE PAGE 2 IF NEEDED FOR EXPLANATION.)**

DATE: _____
CORNER _____

ACCESSORIES:

BEARING-	LINKS-	FEET-

SURVEY RECORD

PRESENT CONDITION: _____

DATE: 1954-57

~~3" HEMLOCK POST~~

PIPE ADDED 1957

~~10" HEMLOCK~~

N 85° E 5.0

GOOD - SCRIBING VISIBLE

~~16" FIR~~

N 88° W 17.7

GOOD - SCRIBING VISIBLE

CORNER SET: PIPE (OSPEL'S)

MAGNETIC DECLINATION: 20°

BEARING AND DISTANCE TO ABOVE IDENTIFIED SURVEY ACCESSORIES:

BEARING-	FEET-	
N 85° E	5.0	10" HEMLOCK
N 88° W	17.7	16" FIR

CS 5-10-5

ACCESSORIES ADDED THIS DATE:

	BEARING-	FEET	ORIG. BT	W ² -NAIL	PLATE	BRASS DISC
10" HEMLOCK	N 85° E	4.8		X	X	
16" HEMLOCK	N 89° W	7.7		X	X	

IDENTIFIED ON PHOTO:

INFORMATION ON LOCATION OF CORNER AS NOW SET:

DESCRIPTION OF GROUND COVER AND GROUND SLOPE AT CORNER: IN GREEN TIMBER

FROM CORNER NORTH: 70' TIMBERED TO WEST, 100' TO EAST - HIT LOGGING

SOUTH: TIMBERED

EAST: LEVEL TIMBERED

WEST: 40' 50' THEN LEVEL - TIMBERED

WORK DONE FOR W. T. CO.

BY: Glen McCreary
ENGINEER - SURVEYOR

DATE: OCTOBER 24, 1951

ASSISTED BY: _____

UNDER SUPERVISION OF:

COPIES SENT TO: _____