


PUBLIC LAND CORNERS

LVCE

WEYERHAEUSER TIMBER COMPANY
 SPRINGFIELD BRANCH

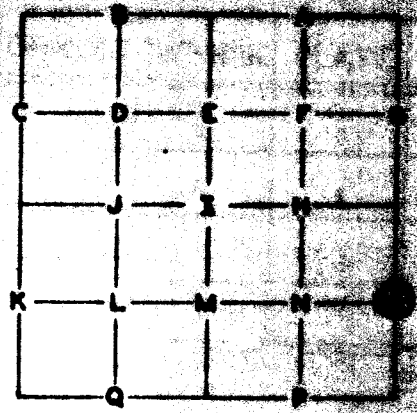

TOWNSHIP 24 S RANGE 2 W
 SECTION 28 CORNER 0 5/16
 COUNTY DOUGLAS OREGON

GLO SURVEY RECORD

DATE: _____
 CORNER _____

PRESENT CONDITION - (DESCRIBE FULLY -
 USE PAGE 2 IF NEEDED FOR EXPLANATION.)

ACCESSORIES:

BEARING-	LINKS--	FEET-

V. HOSFORD SURVEY RECORD
 DATE: 1953 (7)

PRESENT CONDITION: _____

4" CEDAR POST
 18" CEDAR N 16° E 30.8'
 24" CEDAR N 50° W 41.6'

PIPE ADDED 1957
 SCRIPING VISIBLE - GOOD CONDITION
 SCRIPING VISIBLE - GOOD CONDITION

CORNER SET: PIPE (HOSFORD'S) MAGNETIC DECLINATION: 20°

BEARING AND DISTANCE TO ABOVE IDENTIFIED SURVEY ACCESSORIES:

BEARING-	FEET-
N 50° W	41.6
N 17° E	30.8

CS 5/10-7

(u)

ACCESSORIES ADDED THIS DATE:

	BEARING-	FEET	ORIG. BT	W ² -NAIL	PLATE	BRASS DISC
24" CEDAR	N 49° W	40.9		X	X	
18" CEDAR	N 17° E	30.3		X	X	

IDENTIFIED ON PHOTO:

INFORMATION ON LOCATION OF CORNER AS NOW SET:

DESCRIPTION OF GROUND COVER AND GROUND SLOPE AT CORNER: AT EAST EDGE CAT
PIRE TRAIL

FROM CORNER NORTH: 52 00 TO WEST LOGGED TO EAST

SOUTH: 52 LOGGED TO EAST AND TO WEST

EAST: LEVEL 90 LOGGED TO WEST AND SOUTH

WEST: 52 90 SP. BR. PLUMS SOUTH, CORNER TO NORTH,
LOGGED TO SOUTH

WORK DONE FOR W. T. CO.

BY: Glen M. Cheaney
ENGINEER - SURVEYOR

DATE: OCTOBER 24, 1951

ASSISTED BY: _____

UNDER SUPERVISION OF:

COPIES SENT TO: _____

SEAL