


PUBLIC LAND CORNERS

WEYERHAEUSER TIMBER COMPANY
 SPRINGFIELD BRANCH

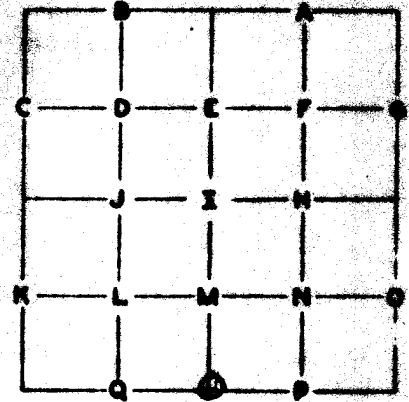

TOWNSHIP 24 S RANGE 2 W
 SECTION 15 CORNER S 1/4
 COUNTY DOUGLAS OREGON

GLO SURVEY RECORD

DATE: 1894

CORNER _____

PRESENT CONDITION - (DESCRIBE FULLY -
 USE PAGE 2 IF NEEDED FOR EXPLANATION.)

ACCESSORIES:

	BEARING-	LINKS-	FEET-	
6" VINE MAPLE	N 5° E	35	23.7	FOUND - BARK SCRIBED - GOOD CONDITION
6" VINE MAPLE	S 82° E	11	7.3	NO TRACE

MOSFORD SURVEY RECORD
 DATE: SEPTEMBER 13, 1957

PRESENT CONDITION: _____

2" IRON PIPE				IN CORRECT POSITION
12" HEMLOCK	N 1/2° W	24.2'		SCRIBED - GOOD CONDITION
24" HEMLOCK	S 85 1/2° E	65.2'		SCRIBED - GOOD CONDITION

CORNER SET: 2" I.P. (MOSFORD'S) MAGNETIC DECLINATION: 20°

BEARING AND DISTANCE TO ABOVE IDENTIFIED SURVEY ACCESSORIES:

BEARING-	FEET-	
N 5° E	24	6" ORIGINAL VINE MAPLE
N 1/2° W	24.2	12" HEMLOCK
S 85 1/2° E	65.2	24" HEMLOCK

CS 53/110-10

ACCESSORIES ADDED THIS DATE:

	BEARING-	FEET	ORIG. BT	W ² -NAIL	PLATE	BRASS DISC
48" FIR	N 82° E	37.4		X	X	
56" FIR	N 20° W	6.4		X	X	

IDENTIFIED ON PHOTO:

INFORMATION ON LOCATION OF CORNER AS NOW SET:

DESCRIPTION OF GROUND COVER AND GROUND SLOPE AT CORNER: IN CAT FIRE TRAIL

FROM CORNER NORTH: * 10% GREEN TIMBER TO EAST AND WEST

SOUTH: LOGGED TO EAST AND WEST

EAST: * 5% LOGGED TO SOUTH - GREEN TIMBER TO NORTH

WEST: * 5% LOGGED SOUTH - GREEN TIMBER NORTH

WORK DONE FOR W. T. CO.

BY: *Glenn M. Cheaney*
ENGINEER - SURVEYOR

DATE: OCTOBER 23, 195

ASSISTED BY: _____

UNDER SUPERVISION OF:

COPIES SENT TO: _____

SEAL